
FORM 51 25M 8-50 WESTERN Sumner KANSAS

Section 9 Township 30 Range 1 E

Well No. # 1 Stunkle

Company J. P. Gaty

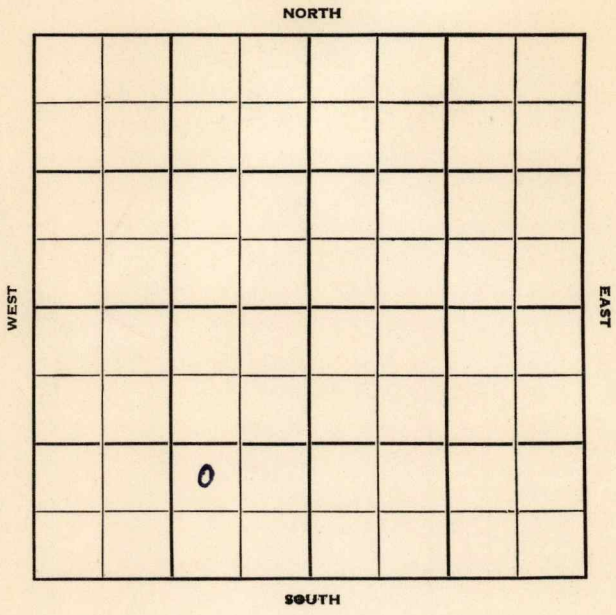

FORM 252-B
10M 8-51 TPCO.

Sumner

KANSAS ✓

Sec. 9 Twp. 30 R. 1E

Well No. #1 Stunkle Farm

J. P. Gaty Company

Morrison Drlg. Contractor

Wildcat


Ft. from N. Line

990 Ft. from S. Line

990 Ft. from E. Line

Ft. from W. Line

NW SE SW

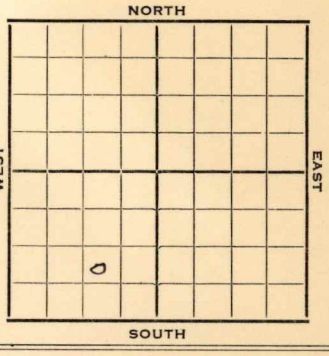

1952	Elev. 1241 REPORT
6/11	Spud 6-9-52 8" @ 195'
6/18	Drlg. 2876'
6/25	KC 2750 Miss 3350 Simp. 3804-05 RTD 5" @ 3805'
7/2	DD 3841' TD HFW Shut down
7/9	"
7/16	Spud 6-9-52 D&A TD 3841 8" @ 195 KC 2750 Miss 3350 Simp 3804 5" @ 3805 TD 3841 HFW D&A

ABANDONED

FORM 275 FOR SALE BY KANSAS BLUE PRINT CO


County Sumner State KANSAS

Sec. 9 (Blk. Twp.) 30 (Sur. Rge.) 1E Map No.

Operator J. P. Gaty

Well No. 1 Farm Stunkle

Elev. Location NW SE SW

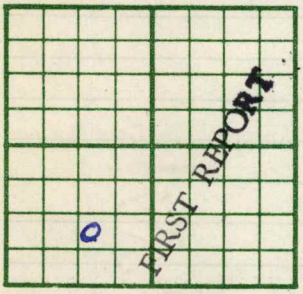

990 Ft. From S Line SW

990 Ft. From E Line Quarter

1st. Report JUN 11 1952

Completion

Remarks Morrison Drlg. - Contr.

Spudding Date 6-9-52

Drlg. Data Wildcat

8" @ 195

J. G. McGEHEE

FORM 275 FOR SALE BY KANSAS BLUE PRINT CO.


County Sumner State Kansas

Sec. 9 (Blk. Twp.) 30 (Sur. Rge.) 1E Map No.

Operator J. P. Gaty

Well No. 1 Farm Stunkle

Elev. 1241 Location NW SE SW

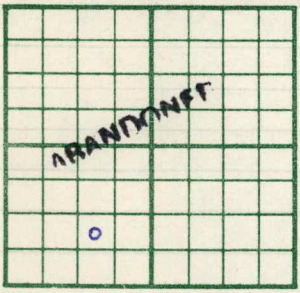

990 Ft. From S Line SW

990 Ft. From E Line Quarter

1st. Report

Completion JUL 16 1952

Remarks Wildcat

Morrison Drlg. - Contr.

Spudding Date 6-9-52

Drlg. Data D & A TD 3841

8" @ 195 KC 2750 Miss. 3350

Simp. 3804 5" @ 3805 TD 3841 HFW

D & A

J. G. McGEHEE