


Section 10 Township 30 Range 1E

Well No. 1 Wilson

Company Ryan Drlg.

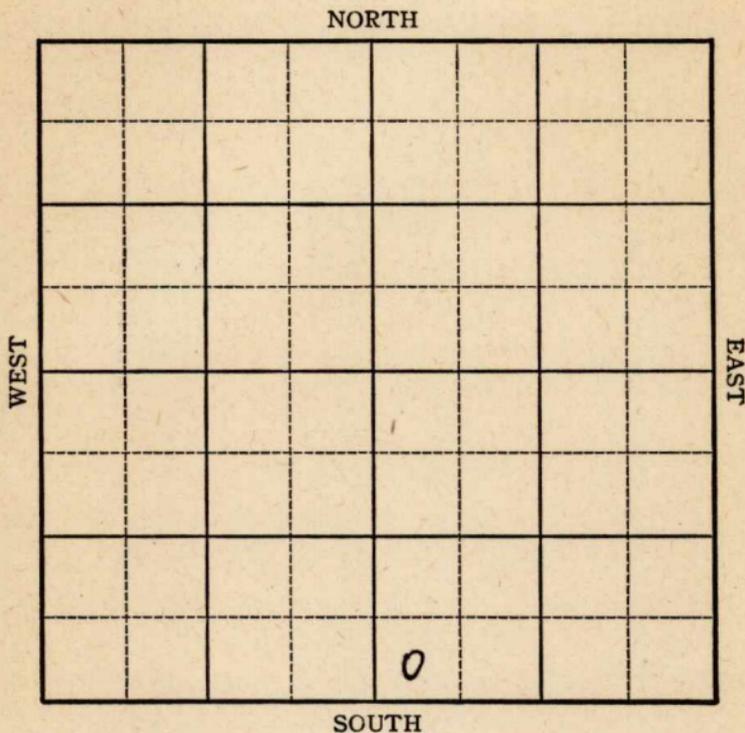

KANSAS

Summer County ✓

Sec. 10 Twp. 30 R. 1E

Well No. #1 Wilson Farm _____

Ryan Drlg. Company _____


Bellman

_____ Ft. from N. Line

330 Ft. from S. Line

_____ Ft. from E. Line

330 Ft. from W. Line

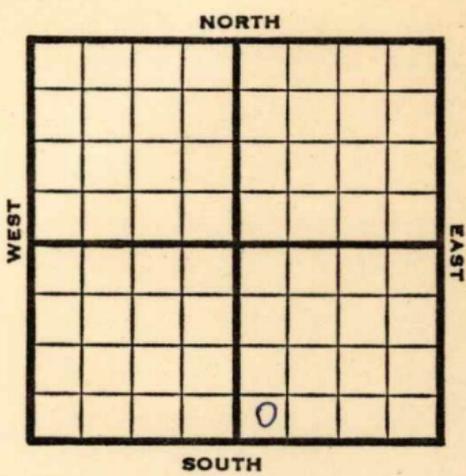

SW SE

1946 **Elev. 1244** REPORT

5/1 Location
5/7 8" @ 190
Drlg. 2015'

5/14 **Lans 2733**
Miss 3329
Drlg 3747'

5/22 **Arb. 3852**
TD 3871'

ABANDONED

Kansas Pool Name Bellman

KANSAS

Map No. 18 Sec. 10 Twp. 30 R. 1E

Well No. 1 Wilson

Ryan Drlg. Company

FIRST REPORT

Contractor

SW SE

SECTION PLAT

 Ft. from N. Line

330 Ft. from S. Line

 Ft. from E. Line

330 Ft. from W. Line

| | | | |
|--|--|--|--|
| | | | |
| | | | |
| | | | |
| | | | |

Sumner County

Location X

Rig up

Drilling and Remarks:

RECORD

Cased in., ft.

Sand

Gas

Oil

Total Depth

PRODUCTION

1st 24 hrs. Nat.

1st 24 hrs. after shot

Gas Cu. Ft.

Dry Hole

Abandoned

Date

MAY 1 1946 19

S. J. LEWIS Scout

