


Section 15 Township 30 Range 1E

Well No. #2, Bellman

Company Summit Drlg.

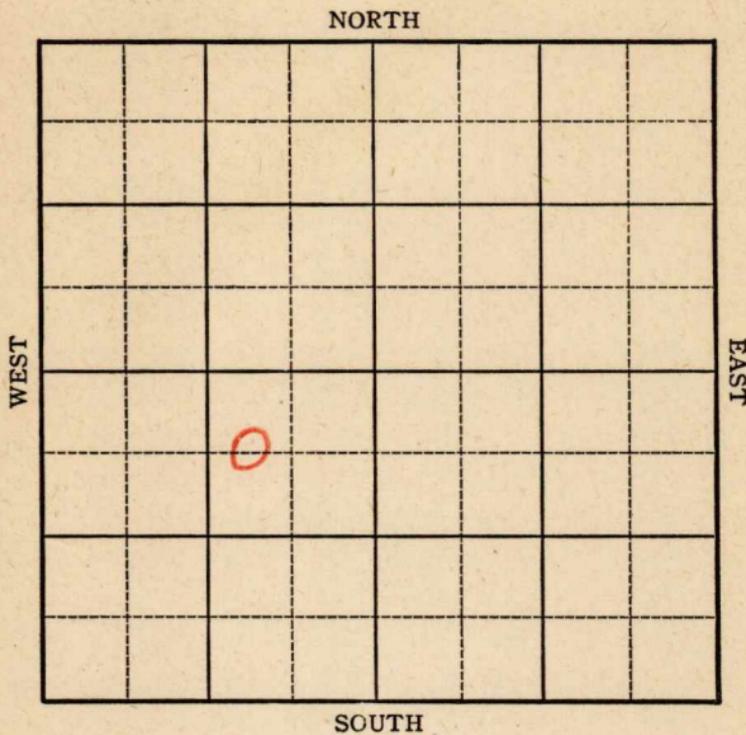

Sec. 15 Twp. 30 R. 1E

Well No. #2 Bellman Farm _____

Summit Drlg. Company _____


Bellman

660 Ft. from N. Line

_____ Ft. from S. Line

990 Ft. from E. Line

_____ Ft. from W. Line

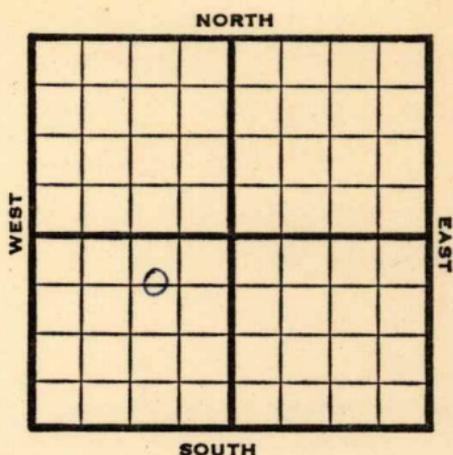

CWL NE SW

Elev. 1242

REPORT

1946

- 4/17 Location
- 4/23 RUR
- 5/1 10" @ 160
Drlg 2100
- 5/7 **Lans 2724**
Miss 3340
Simp sd 3791-93
TD Run 7"
- 5/14 8" @ 3798'
TD 3803 swb 10 oil in 2 hrs.
- 5/21 " " "
- 5/29 " " "
- 6/5 " " "
- 6/12 " " "
- 6/18 " " "
- 6/26 **Simp. 3799**
7" @ 3798
TD 3803
Pump 140 Pot.
Grav. 44.0

COMPLETED

KANSAS

Kansas Pool Name Bellman

Map No. 12 Sec. 15 Twp. 30 R. 1E

Well No. 2 Bellman

Summit Drlg. Company

FIRST REPORT Contractor

C W L NE SW

SECTION PLAT

660 Ft. from N. Line

_____ Ft. from S. Line

990 Ft. from E. Line

_____ Ft. from W. Line

	0		

Sumner County

Location X

Rig up _____

Drilling and Remarks:

RECORD

Cased _____ in., _____ ft.

Sand _____

Gas _____

Oil _____

Total Depth _____

PRODUCTION

1st 24 hrs. Nat. _____

1st 24 hrs. after shot _____

Gas _____ Cu. Ft.

Dry Hole _____

Abandoned _____

Date

APR 17 1946 19 _____

S. J. LEWIS Scout

KANSAS

Kansas Pool Name Bellman Pool

Map No. 12 Sec. 15 Twp. 30 R. 1E

Well No. 2 Bellman

Summit Drlg. Company

COMPLETED Contractor

C W L NE SW

E 1, 1242
SECTION PLAT

660 Ft. from N. Line

 Ft. from S. Line

990 Ft. from E. Line

 Ft. from W. Line

	0		

Sumner County

Location

Rig up

Drilling and Remarks:

Strip 3799
7" 3799.
Puny 140 808

44-9-92

RECORD

Cased in., ft.

Sand

Gas

Oil

Total Depth 3803

PRODUCTION

1st 24 hrs. Nat.

1st 24 hrs. after shot

Gas Cu. Ft.

Dry Hole

Abandoned

Date

JUN 26 1946 19

S. J. LEWIS Scout