


Section 15 Township 30 Range 1E

Well No. #2 ~~Fox~~ COX

Company Sunray

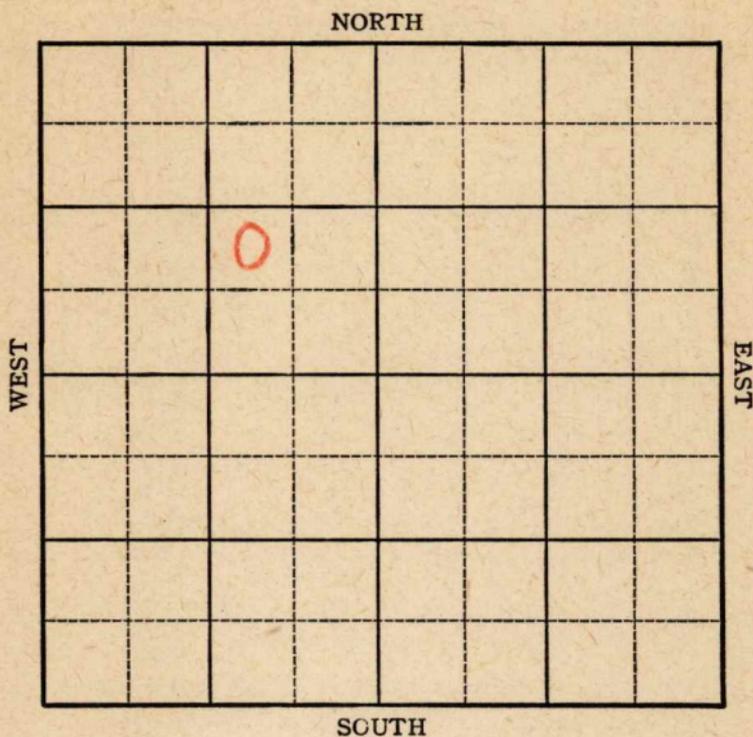

KANSAS

Summer County

Sec. 15 Twp. 30 R. 1E

Well No. #2 Fox Cox Farm _____

Sunray

Company _____

Miscellaneous _____


_____ Ft. from N. Line

990 Ft. from S. Line

990 Ft. from E. Line

_____ Ft. from W. Line

NW SE NE NW

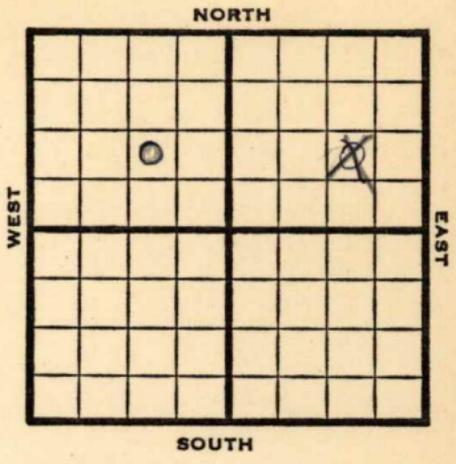

1946

REPORT

Elev. 1239

- 2/13 8" @ 215
Drlg. 270'
- 2/21 K.C. 2728' Miss 3332'
Drlg. 3367'
- 2/28 Simp 3789-91' T.D. 5" - 3790'
RUST.
- 3/7 T.D. 3792' Swab 160 oil in 5 hours.
- 3/14 " "
- 3/21 " "
- 3/28 " "
- 4/4 " "
- 4/10 Simp. 3789
5" @ 3790
TD 3792
Bomb Pot. 1002
Grav. 38.0

COMPLETED

KANSAS

Kansas Pool Name Bellman

Map No. 12 Sec. 15 Twp. 30 R. 1E

Well No. 2 Cox

Sunray Company

COMPLETED

Contractor

NW SE NW

E 1259

SECTION PLAT

	o		

_____ Ft. from N. Line
990 Ft. from S. Line
990 Ft. from E. Line
 _____ Ft. from W. Line

Sumner County

RECORD

Location _____

Rig up _____

Drilling and Remarks:

Surf 3789
5" 00790
Born + RT 1002

Cased _____ in., _____ ft.
 Sand _____
 Gas _____
 Oil _____
 Total Depth 2792

PRODUCTION

1st 24 hrs. Nat. _____
 1st 24 hrs. after shot _____
 Gas _____ Cu. Ft.
 Dry Hole _____
 Abandoned _____

38-42

Date

APR 10 1946 19

S. J. LEWIS Scout