


Section 15 Township 30 Range 1E

Well No. #4, Cox

Company Sunray Oil

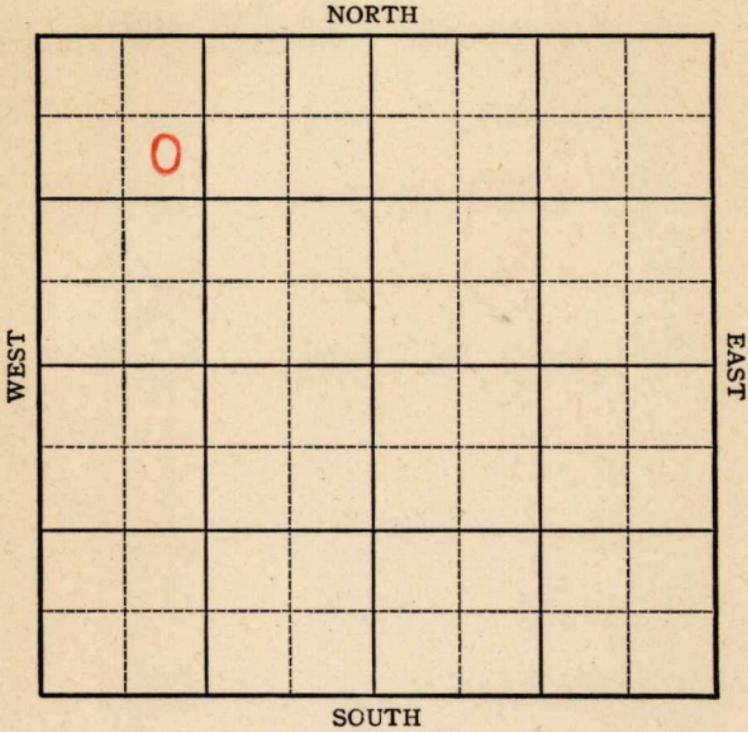

**KANSAS**

Sumner County

Sec. 15 Twp. 30 R. 1E


Well No. #4 Cox Farm \_\_\_\_\_

Sunray Oil Company \_\_\_\_\_

Bellman

NORTH

990 Ft. from N. Line

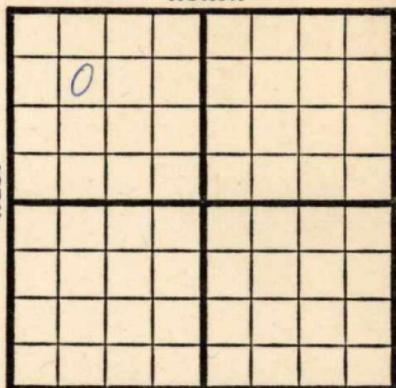

\_\_\_\_\_ Ft. from S. Line

\_\_\_\_\_ Ft. from E. Line

990 Ft. from W. Line

SOUTH

SE NW NW

1946 **Elev. 1241** REPORT

3/27 8" @ 192'  
Drlg. 285'

4/4 **Lans. 2741**  
Drlg. 3250

4/10 **Miss 3339**  
**Simp sd 3793**  
?TD 3796-5" @ 3784 RUST

4/16 **Arb 3864-**  
TD 3885 82' of 4" liner @  
3886 WOC

4/23 " " "

5/1 **Arb. 3864**  
5" @ 3794  
87' of 4" liner @ 3876  
TD 3891' SWD

**ABANDONED**

Kansas Pool Name Bellman

**KANSAS**

Map No. 12 Sec. 15 Twp. 30 R. 1E

Well No. 4 Cox

Sunray Oil Company

FIRST REPORT Contractor

SE NW NW

SECTION PLAT

990 Ft. from N. Line

\_\_\_\_\_ Ft. from S. Line

\_\_\_\_\_ Ft. from E. Line

990 Ft. from W. Line

o			

Sumner County

Location \_\_\_\_\_

Rig up \_\_\_\_\_

Drilling and Remarks:

8" @ 192

Dr1g 285

RECORD

Cased \_\_\_\_\_ in., \_\_\_\_\_ ft.

Sand \_\_\_\_\_

Gas \_\_\_\_\_

Oil \_\_\_\_\_

Total Depth \_\_\_\_\_

PRODUCTION

1st 24 hrs. Nat. \_\_\_\_\_

1st 24 hrs. after shot \_\_\_\_\_

Gas \_\_\_\_\_ Cu. Ft.

Dry Hole \_\_\_\_\_

Abandoned \_\_\_\_\_

Date

MAR 27 1946 19 \_\_\_\_\_

S. J. LEWIS

Scout

**KANSAS**

Kansas Pool Name Bellman

Map No. 12 Sec. 15 Twp. 30 R. 1E

Well No. 4 Cox

Sunray Oil Company

**ABANDONED**

Contractor

SE NW NW

*E 1, 1241*

SECTION PLAT

990 Ft. from N. Line

         Ft. from S. Line

         Ft. from E. Line

990 Ft. from W. Line


**Summer County**

Location                                 

Rig up                                 

Drilling and Remarks:

*CR 73864*  
*5" @ 3794.*  
*87' 2 1/4" lined @ 3876*  
*BWJ*

**RECORD**

Cased          in.,          ft.

Sand                                 

Gas                                 

Oil                                 

Total Depth 3897

**PRODUCTION**

1st 24 hrs. Nat.                         

1st 24 hrs. after shot                         

Gas                          Cu. Ft.

Dry Hole                         

Abandoned                         

Date

MAY 1 1946

19

S. J. LEWIS

Scout