


Section 19 Township 12 Range 15W

Well No. #1 Ginther

Company Floyd L. Kirkman et al

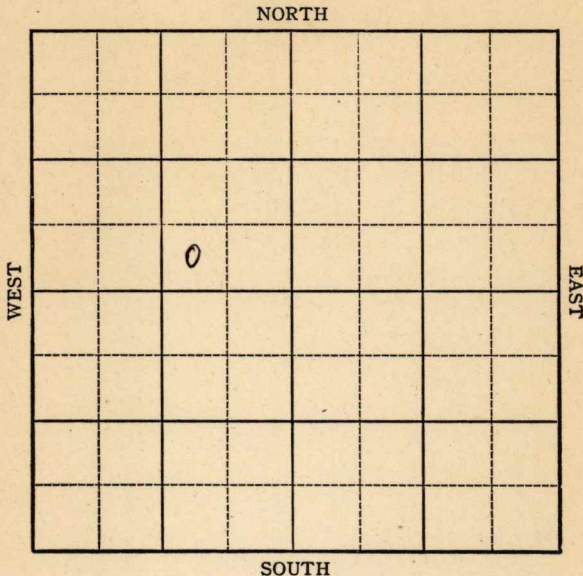

KANSAS

Sec. 19 Twp. 12 R. 15W

Well No. #1 Ginther Farm  
Floyd L. Kirkman et al Company

Fairport


\_\_\_\_\_ Ft. from N. Line

280 \_\_\_\_\_ Ft. from S. Line

940 \_\_\_\_\_ Ft. from E. Line

\_\_\_\_\_ Ft. from W. Line

SW SE NW

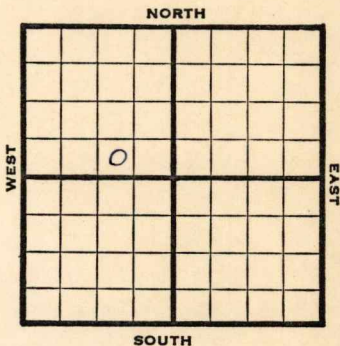

1946

REPORT

7/24 Twin #1 which has been abandoned.  
 Lans. 3001  
 8" @ 3050  
 TD 3058'  
 Pung 200' Pot.

FIRST REPORT

&

COMPLETED

**KANSAS** Kansas Pool Name Fairport

Map No. 72 Sec. 19 Twp. 12 R. 15W

Well No. 1 Ginther

Floyd L. Kirkman et al. Company

**FIRST REPORT**

Contractor

SW SE NW

*and*  
**COMPLETED**

SECTION PLAT

*Twin*

Ft. from N. Line

280 Ft. from S. Line

940 Ft. from E. Line

Ft. from W. Line

	o		

Russell County

Location \_\_\_\_\_

Rig up \_\_\_\_\_

Drilling and Remarks:

Twin # 1 which has been abandoned

Lans. 3001'

8" @ 3050'

TD 3058'

Pung. 200' Pot.

**RECORD**

Cased \_\_\_\_\_ in., \_\_\_\_\_ ft.

Sand \_\_\_\_\_

Gas \_\_\_\_\_

Oil \_\_\_\_\_

Total Depth 3058'

**PRODUCTION**

1st 24 hrs. Nat. \_\_\_\_\_

1st 24 hrs. after shot \_\_\_\_\_

Gas \_\_\_\_\_ Cu. Ft.

Dry Hole \_\_\_\_\_

Abandoned \_\_\_\_\_

Date

JUL 24 1946 19

S. J. LEWIS Scout