

Cowley

KANSAS

SECTION 11 TOWNSHIP 33S RANGE 3E

WELL NO. #4 Boyles


COMPANY Wakefield Drlg.

NORTH

*NW NE
NE NW SW*

WEST

EAST

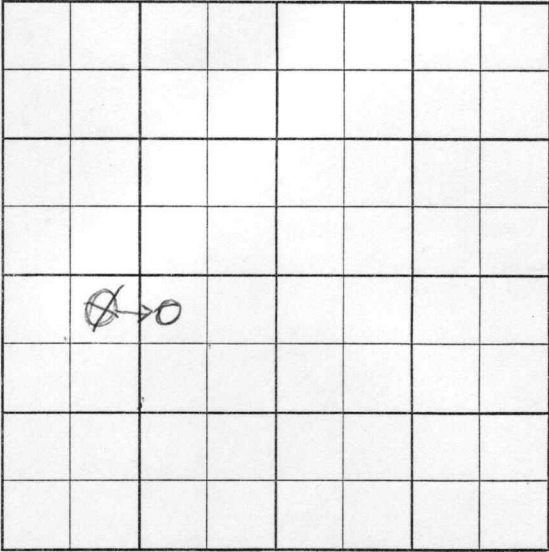

SOUTH

CO. Cowley ELEV. _____
SEC. 11 TWP. 33 RGE. 3E
COMPANY Wakefield Drlg. NO.4

FIRST REPORT

JAN 7 1958

FARM Boyle
LOC. NE NW SW

GEOL. _____
CONTR. Co. Tools
POOL Graham
SPUD 12/29/57
8" @ 128, Drlg. 755

~~129~~

CO.
LSE.
NO.
SEC.
TWP.
RGE.

