


Section 15 Township 30 Range 1-E

Well No. #3 Cox

Company Sunray

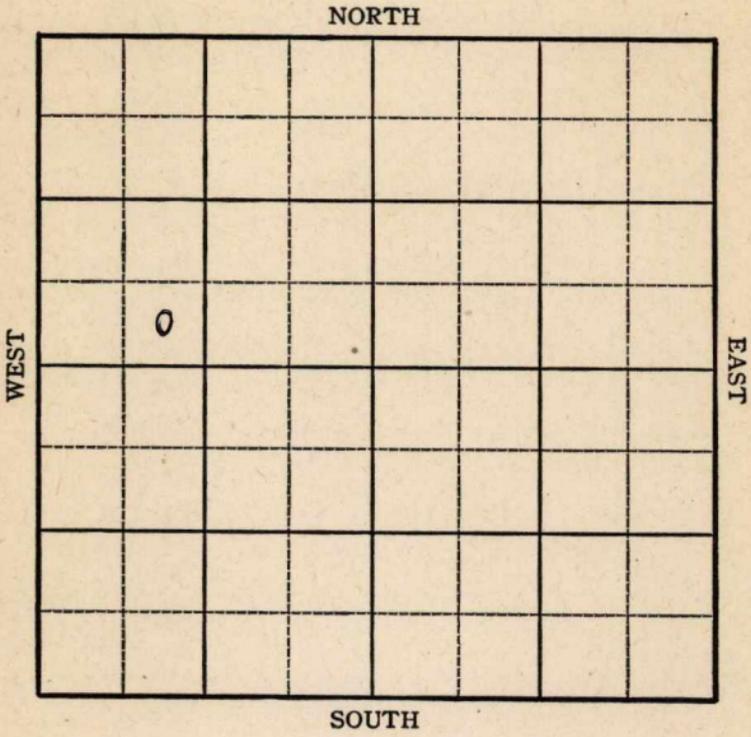

Sec. 15 Twp. 30 R. 1E

Well No. #3 Cox Farm

Sunray Company

Bellman


Ft. from N. Line

330 Ft. from S. Line

Ft. from E. Line

990 Ft. from W. Line

SE SW NW

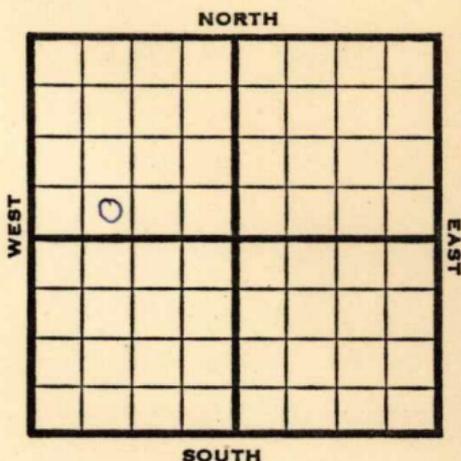

1946 **Elev. 1237** REPORT

3/6	8" @ 218'			
	425'			
3/14	K.C. 2738'			
	Drlg. 3100'			
3/21	Miss 3441'	Simp 3794'		
	T.D. 3799'	5" - 3795'		
	RUST.			
3/28	T.D. 3803'	Pump 2 oil per hour 2 hours.		
4/4	" "	" "	" "	" "
4/10	" "	" "	" "	" "
4/16	" "	" "	" "	" "
4/23	" "	" "	" "	" "
5/1	" "	" "	" "	" "
5/7	" "	" "	" "	" "
5/15	Simp. 3794			
	5" @ 3795			
	TD 3803'			
	Pump 40 Pot.			
	Grav. 43.0			

COMPLETED

