


Cowley

KANSAS

SECTION 11 TOWNSHIP 33S RANGE 3E

WELL NO. #3 Kukuk

COMPANY Crest Petro.

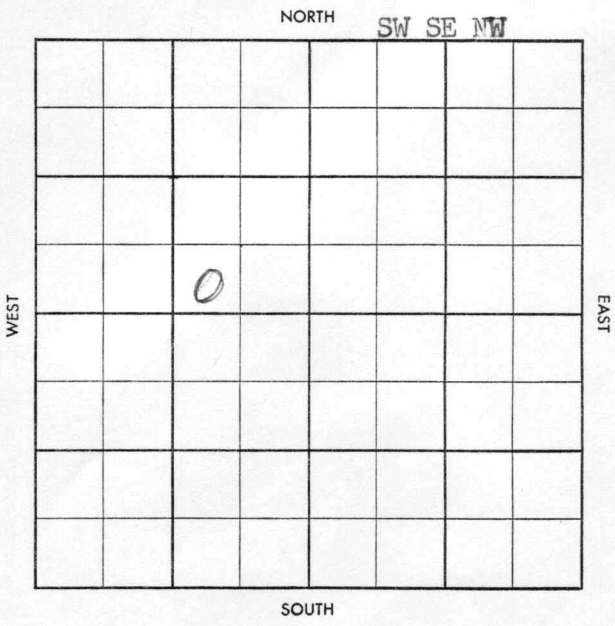

29

County Cowley Elev. _____Sec. 11 Twp. 33 Rge. 3ECompany Crest PetroleumFarm Name Kukuk No. 3

TOPS	DEPTH	LOG	DATUM
Anh. _____			
Tp. _____			
H. _____			
Tr. _____			
Dg. _____			
B.L. _____			
L. _____			
K.C. _____			
B.K.C. _____			
Ce. _____			
C. _____			
M. _____			
M. _____			
K. _____			
Mz. _____			
Mq. _____			
V. _____			
S. _____			
S. _____			
A. _____			
R. _____			
Pf. _____			
G. _____			
T.D. _____			

Loc. in Sec. _____


SW SE NW

Geol. _____

Contr. _____

Wrico Tools

Pool _____

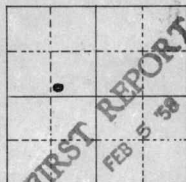Graham

Date Comm. _____

RURT

Co.

Lse.

No.

Sec.

T.

R.

Twp. 11 Pool 11
 Co. 3 Facet 3

S-513.B

County Cowley Elev. 1151
 Sec. 11 Twp. 33 Rge. 3E
 Company Crest Petroleum
 Farm Name Kukuk No. 3

TOPS	DEPTH	LOG	DATUM
Anh.			
Tp.			
H.			
Tr.			
Dg.			
B.L. <u>Sta1</u>	<u>2208</u>		
L. <u>Lay</u>	<u>2620</u>		
K.C. <u>27</u>	<u>2794</u>		
B.K.C. <u>Marm</u>	<u>2972</u>		
Ce.	<u>3088</u>		
C. <u>Bontz</u>	<u>3243</u>		
M. <u>Bontsd</u>	<u>3274</u>		
M.			
K.			
Mz.			
Mq.			
V.			
S.			
S.			
A.			
R.			
Pf.			
G.			
T.D.	<u>3278</u>		

Loc. in Sec. SW SE NW

Geol. _____
 Contr. _____
Wrico Tools

Pool Graham

COMPLETE
 APR 30 '58

Date Comm. 2-4-58
 RURT FEB 12 '58 8" 125 5 1/2" 3275 WOCT
 FEB 13 '58 MICT 3278
 FEB 12 '58 \$ 4280 NW 8 hrs
 to Evac MAR 19 '58 250 A after \$
 +st DD 3280 TD APR 2 '58
 from \$10.50 9580 +trw 8 hrs
 pop APR 16 '58 APR 23 '58 APR 30 '58
 7/25 hr to water
 Br.