

KANSAS

FORM 51 5M 6-46 PETROL


Sumner County

Section 15 Township 30 Range 1E

Well No. ~~4 Cox~~ #5 Cox

Company Sunray

C E L NW SW  
NORTH

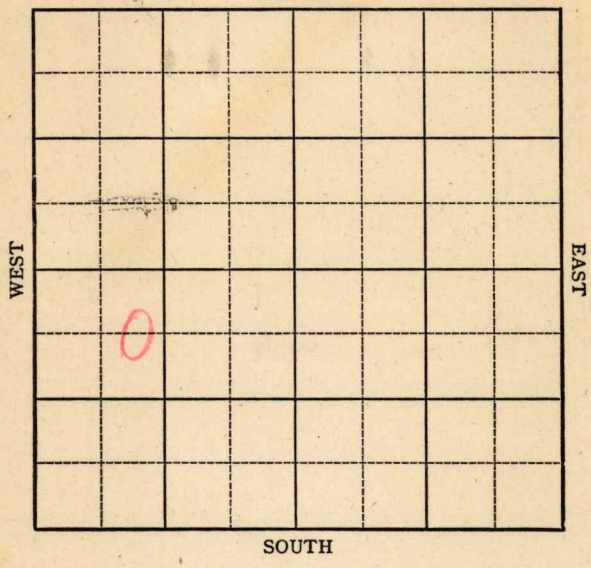

Sec. 15 Twp. 30 R. 1E

Well No. #5 #4 Cox Farm

Sunray Company

Miscellaneous


660 Ft. from N. Line

\_\_\_\_\_ Ft. from S. Line

\_\_\_\_\_ Ft. from E. Line

990 Ft. from W. Line

CEL NW SW

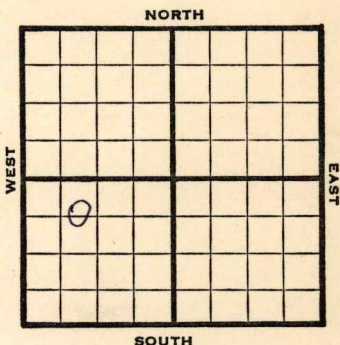

1946 **Elev. 1236'** REPORT

- 8/7 Location
- 8/13 8" @ 109 WOC
- 8/20 **Lans 2738**  
**Miss 3340'**  
Drlg 3470'
- 8/27 **Simp 3790**  
TD 3793  
5" @ 3790 RUST
- 9/5 **Simp 3790'**  
5" @ 3790'  
TD 3793'  
Pump 144 Pot  
42 Grav

**COMPLETED**

Pool Name Miscellaneous

Kansas

Map No. 12 Sec. 15 Twp. 30 R. 1E

Well No. 5 Cox

Sunray

Company

**COMPLETED**

Contractor

C E L NW SW

*E 1, 1236.*  
SECTION PLAT

660 Ft. from N. Line

\_\_\_\_\_ Ft. from S. Line

\_\_\_\_\_ Ft. from E. Line

990 Ft. from W. Line

6			

Sumner County

Location \_\_\_\_\_

Rig up \_\_\_\_\_

Drilling and Remarks:

**RECORD**

Cased \_\_\_\_\_ in., \_\_\_\_\_ ft.

Sand \_\_\_\_\_

Gas \_\_\_\_\_

Oil \_\_\_\_\_

Total Depth 878

**PRODUCTION**

1st 24 hrs. Nat. \_\_\_\_\_

1st 24 hrs. after shot \_\_\_\_\_

Gas \_\_\_\_\_ Cu. Ft.

Dry Hole \_\_\_\_\_

Abandoned \_\_\_\_\_

*Drill 3790  
57" @ 3790  
Pump 144 P/B*

*42 1/2*

Date

SEP 5 1946 19

S. J. LEWIS Scout

Kansas Pool Name Miscellaneous

Map No. 72 Sec. 15 Twp. 30 R. 1E

Well No. 5 Cox

Sunray Company

**CORRECTION**

Contractor

C E L NW SW

SECTION PLAT

660 Ft. from N. Line  
         Ft. from S. Line  
         Ft. from E. Line  
990 Ft. from W. Line


Sumner County

RECORD

Location \_\_\_\_\_

Cased \_\_\_\_\_ in., \_\_\_\_\_ ft.

Rig up \_\_\_\_\_

Sand \_\_\_\_\_

Drilling and Remarks:

Gas \_\_\_\_\_

Oil \_\_\_\_\_

Reported as  
#4 Cox

Total Depth \_\_\_\_\_

PRODUCTION

1st 24 hrs. Nat. \_\_\_\_\_

1st 24 hrs. after shot \_\_\_\_\_

Gas \_\_\_\_\_ Cu. Ft.

Dry Hole \_\_\_\_\_

Abandoned \_\_\_\_\_

Date

AUG 14 1946 19

S. J. LEWIS Scout

KANSAS

Kansas Pool Name Miscellaneous

Map No. 12 Sec. 15 Twp. 30 R. 1E

Well No. 4 Cox

Sunray Company

FIRST REPORT

Contractor

C E L NW SW

SECTION PLAT

660 Ft. from N. Line

\_\_\_\_\_ Ft. from S. Line

\_\_\_\_\_ Ft. from E. Line

990 Ft. from W. Line


Sumner County

Location X

Rig up \_\_\_\_\_

Drilling and Remarks:

RECORD

Cased \_\_\_\_\_ in., \_\_\_\_\_ ft.

Sand \_\_\_\_\_

Gas \_\_\_\_\_

Oil \_\_\_\_\_

Total Depth \_\_\_\_\_

PRODUCTION

1st 24 hrs. Nat. \_\_\_\_\_

1st 24 hrs. after shot \_\_\_\_\_

Gas \_\_\_\_\_ Cu. Ft.

Dry Hole \_\_\_\_\_

Abandoned \_\_\_\_\_

Date

AUG 7 1946 19 \_\_\_\_\_

S. J. LEWIS Scout