

Section 11 Township 33 Range 3 E

Well No. # 1 Priest

Company ~~K. T. Weidemann~~ Frank Taylor

NORTH *B*

WEST

EAST

SOUTH

Cowley

KANSAS

SEC. 11	TWP. 33	R. 3E	✓
------------	------------	----------	---


WELL NO. #1 Priest FARM

COMPANY K.T. Weidemann

CONTRACTOR Weidemann

Wildcat.

330 _____ Ft. from N. Line
 _____ Ft. from S. Line
 _____ Ft. from E. Line
 330 _____ Ft. from W. Line

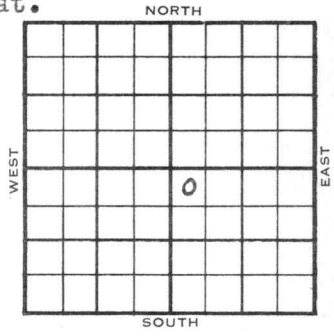

NW NW SE

	ELEVATION	REPORT
1953	--	
12/30		Location
1954 1/13		Spud 12-29-53 D&A TD 3289 10" @95' Bart 3275', Miss 3281', DST 3281-89', opn 1 hr., rec.45' mud, 265# TD 3289 D&A
		ABANDONED

O.W.W.O.

~~Pool~~ ~~Pool~~ ~~Pool~~ 24

County Cowley Elev. _____
 Sec. 11 Twp. 33 Rge. 3E
 Company Frank Taylor
 Farm Name Priest No. 1

TOPS	DEPTH	LOG	DATUM
Anh.			
Tp.			
H.			
Tr.			
Dg.			
B.L.			
L.			
K.C.			
B.K.C.			
Ce.			
K Btvl	3275		
M.	3281		
M.			
K.			
Mz.			
Mq.			
V.			
S.			
S.			
A.			
R.			
Pf.			
G			
OTD	3289		
T.D.			

Loc. in Sec. _____

NW NW SE

(O.W.W.O.)

O.W.W.O.

Geol. _____

Contr. _____

Crisswell

Pool _____

Graham



Date Comm. _____

OLD INFO: was K.T. Weidemann, #1 Priest.

was D & A.

NEW INFO: WORT to wash down & run 5"

Co.
Lse.
No.
Sec.
T.
R.

Twp. ~~Pool~~
 Co. ~~Facet~~

O.W.W.O.

S-513-B

County Cowley Elev. _____
 Sec. 11 Twp. 33 Rge. 3E
 Company Frank Taylor
 Form Name Priest No. 1

TOPS	DEPTH	LOG	DATUM
Anh.			
Tp.			
H.			
Tr.			
Dg.			
B.L.			
L.			
K.C.			
B.K.C.			
Ce.			
<u>z Btvl</u>	<u>3275</u>		
M.	<u>3281</u>		
M.			
K.			
Mz.			
Mq.			
V.			
S.			
S.			
A.			
R.			
Pf.			
<u>OTD</u>	<u>3289</u>		
T.D.			

Loc. in Sec. _____
NW NW SE
(O.W.W.O.)
O.W.W.O.
 Geol. _____
 Contr. _____
Crisswell
 Pool _____
Graham

ABANDONED
 APR 23 '58

Date Comm. _____
 OLD INFO: was K.T. Weidemann, #1 Priest.
was D & A.

NEW INFO: WORT to wash down & run 5"
APR 23 '58
CD DD 3293 TD DST 3281-
3293 of 4 hrs run 350' M BHP
750

D & A

Co.
 Sec.
 No.
 Sec.
 T.
 R.