


Cowley

KANSAS

Section 12 Township 33 Range 3E

Well No. #1 Allen

Company Laura Jane Oil Company

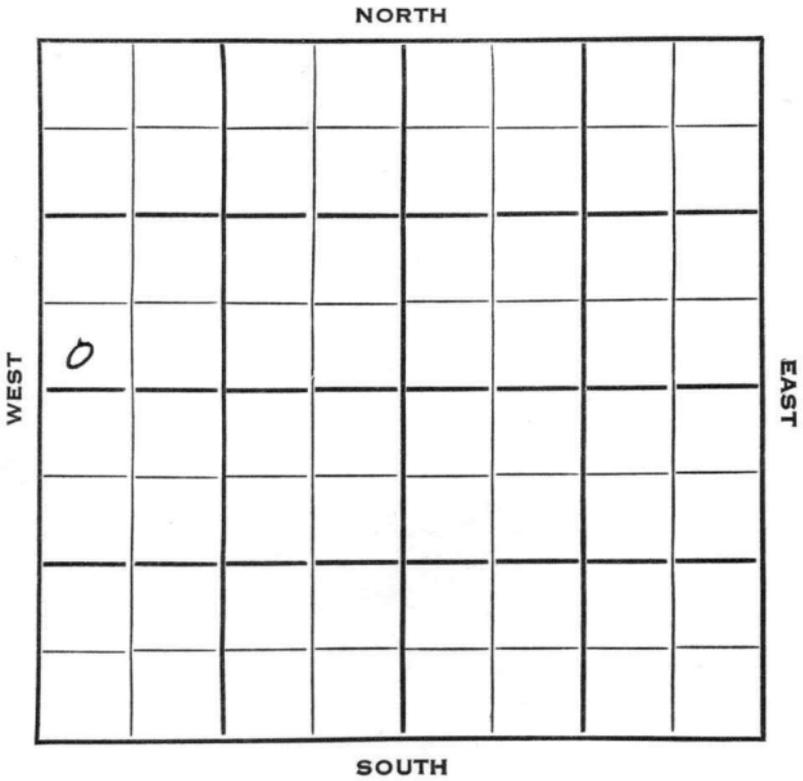

Cowley

KANSAS ✓

Sec. 12 Twp. 33 R. 3E

Well No. #1 Allen Farm

Laura Jane Oil Company Company

Laura Jane - Contr. Contractor


_____ Ft. from N. Line

330 Ft. from S. Line

_____ Ft. from E. Line

330 Ft. from W. Line

SW SW NW
Sunray - Support

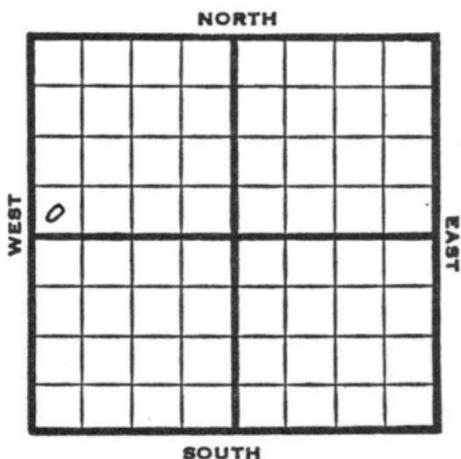

1953

Elev. 1171' REPORT

3/11

M I M

4/29

Spud 3-10-53
 Oil well TD 3293 8" @ 105
 Layton 2606 KC 2790 Bart 3231
 Miss 3279 TD 3293 5" @ 3281
 CO to 3293 HFW PB 3280 48/3267-71
 Oil-frac. S/20 BOPH P/40 BO
 80 BWPD
 Comp. 25 BOPD 50 BW

COMPLETED

County Cowley State Kansas

Sec. 12 (Blk. 33 (Sur. 3E Map No. 33)
(Twp.) (Rge.)

Operator Laura Jane

Well No. 1 Farm Allen

Elev. 1171 Location SW SW NW

| | | | | | |
|--|--|--|--|--|--|
| | | | | | |
| | | | | | |
330 Ft. From S Line NW

330 Ft. From W Line Quarter

1st. Report

Completion APR 29 1953

Remarks

Laura Jane - Contr.

Spudding Date 3-10-53

Drlg. Data Oil well TD 3293

8" @ 105 Layton 2606 KC 2790

Bart. 3231 Miss. 3279 TD 3293

5" @ 3281 CO to 3293 HFW PB 3280

48/ 3267-71 oil-frac S/ 20 boph

P/ 40 bo 80 bwpd

Comp. 25 bopd 50 bw