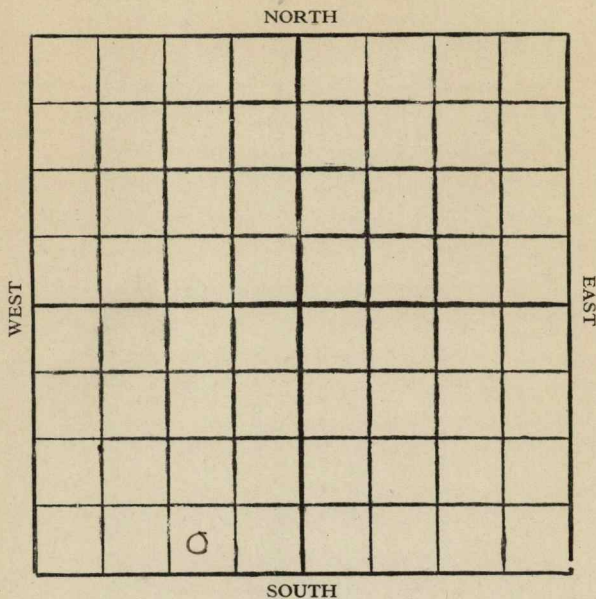


KANSASMap No. _____ Sec. 30 Twp. 12 R. 15WWell No. 34 - Austin Farm _____
Midwest Company _____

Location _____

Drilling Remarks _____

Rig Up _____

Drilling Remarks _____

RECORD

Cased _____ in. _____ ft.

Sand _____

Gas _____

Oil _____

Total Depth _____

PRODUCTION

1st 24 hrs. Nat. _____

1st 24 hrs. after shot _____

Gas _____ cu. ft.

Dry Hole _____

Abandoned _____

KANSASMap No. _____ Sec. 30 Twp. 12 R. 15wWell No. 34 - Austin FarmMid West Company

NORTH

_____ Ft. from N. Line


300 Ft. from S. Line990 Ft. from E. Line

_____ Ft. from W. Line

WEST

EAST

SOUTH

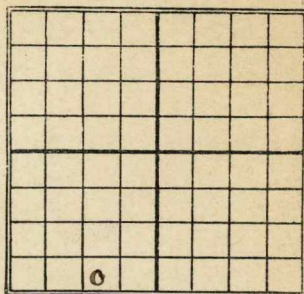1928

Date

REPORT

5/23 Location5/31 _____6/6 _____6/13 _____6/20 _____6/27 _____7/3 _____7/11 _____7/18 _____7/25 _____8/1 _____8/7 _____8/15 _____8/22 _____9/5 _____9/13 _____9/20 D.A. - Abd. Loc.

Map No. KANSAS Sec. 30 Twp. 12 R. 15W

Well No. 34 Austin

Mich West. Company

Contractor

SECTION PLAT

-----Ft. from N. Line

300 Ft. from S. Line

990 Ft. from E. Line

-----Ft. from W. Line

FIRST REPORTS

Location ✓

Rig up -----

Drilling and Remarks:

RECORD

Cased ----- in., ----- ft.

Sand ✓

Gas -----

Oil -----

Total Depth -----

PRODUCTION

1st 24 hrs. Nat. -----

1st 24 hrs. after shot -----

Gas ----- Cu. Ft.

Dry Hole -----

Abandoned -----

Date

MAY 23 1928

S. J. LEWIS

Scout

MAP No. KANSAS SEC. 30 TWP. 12 R. 15N

WELL No. 34 Ruston

Mid West COMPANY

CONTRACTOR

SECTION PLAT

_____ FT. FROM N. LINE

300 FT. FROM S. LINE

990 FT. FROM E. LINE

_____ FT. FROM W. LINE

ABANDONED

LOCATION ✓

RIG UP _____

DRILLING AND REMARKS:

IT & A.

RECORD

CASED _____ IN. _____ FT.

SAND _____

GAS _____

OIL _____

TOTAL DEPTH _____

PRODUCTION

1ST 24 HRS. NAT. _____

1ST 24 HRS. AFTER SHOT _____

GAS _____ CU. FT.

DRY HOLE _____

ABANDONED _____

DATE

SEP 19 1928

192

S. J. LEWIS

SCOUT