

KANSAS

Barton

Section 9 Township 17 Range 13E

Well No. 1 Underwood

Company Phillips & Hanson

Wildcat
NORTH

WEST

EAST

0							

SOUTH

KANSAS

Barton

Sec. 9 Twp. 17 R. 13W ✓

Well No. #1 Underwood Farm

Phillips & Hanson Company

Wildcat


330' Ft. from N. Line

 Ft. from S. Line

 Ft. from E. Line

330' Ft. from W. Line


NW SW

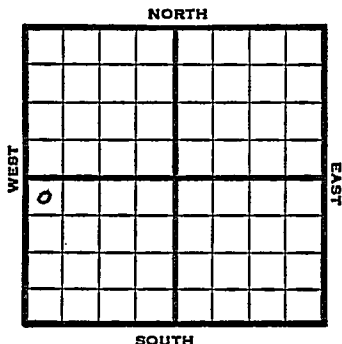

1949 Elev 1887' REPORT

6/15
6/21
6/29

Location
8" @ 250'
Drlg 2870'
TD 3395'
Lans 3134'
Arb. 3377'
Aband
ABANDONED

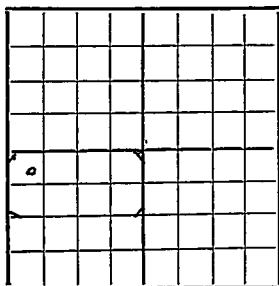Barton County Kansas StateMap No. _____ Sec. 9 Twp. 17 R. 13WWell No. 1 UnderwoodPhillips & Hanson Company_____
NW SW ContractorFIRST REPORT
SECTION PLAT330 Ft. from N. Line_____
Ft. from S. Line_____
Ft. from E. Line330
Ft. from W. LineWildcat
Remarks:

Location

Date
JUN 15 1949

Scout S. J. LEWIS

Map No. K 23 Sec. 9 Twp. 17 R. 13WWell No. 1 UnderwoodPhillips & Hansen Company**ABANDONED**

Contractor

NW SW

El. 1887

SECTION PLAT

2			

330 Ft. from N. Line Ft. from S. Line Ft. from E. Line330 Ft. from W. Line

Barton County

Location Rig up

Drilling and Remarks:

*Lease 3124**Cur 8327?*

RECORD

Cased in., ft.Sand Gas Oil Total Depth 3395

PRODUCTION

1st 24 hrs. Nat. 1st 24 hrs. after shot Gas Cu. Ft.Dry Hole Abandoned

Date

JUN 29 1949

19

S. J. LEWIS

Scout