

Ellis

KANSAS

FORM 51 25M 3-49 PETROL

Section 11 Township 13 Range 17W

Well No. #2 Anderson "C"


Company Cities Service

NORTH

WEST

EAST

SOUTH

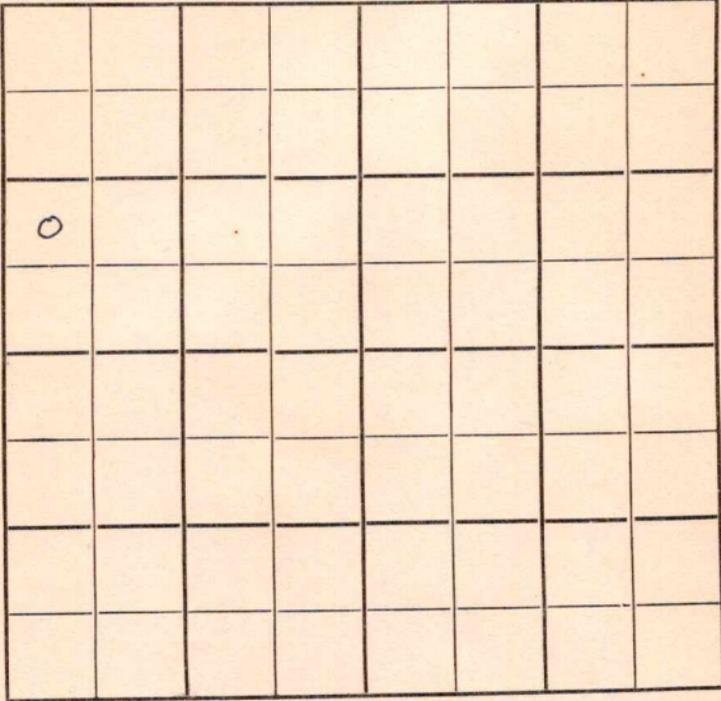

Ellis

KANSAS

Sec. 11 Twp. 13 R. 17W


Well No. #2 Anderson "C" Farm

Cities Service

Company

Catherine Holmes, Contr.)
Pool

NORTH

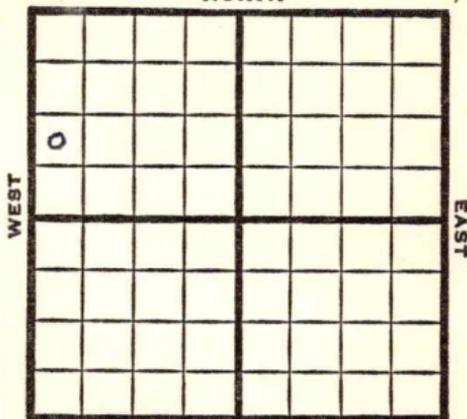

_____ Ft. from N. Line

990' Ft. from S. Line

_____ Ft. from E. Line

330' Ft. from W. Line
NW SW NW

SOUTH

1949 Elev. 2014' REPORT

11/23 Drlg. 1190'

11/29 8" @ 790'

Drlg 3225'

12/7 Lansing 3271'

Arb. 3615-30'

TD 3630'

5" @ 3620'

12/14 Pump 48 bbls oil 24 hrs.

12/21 "

12/28 "

1950

1/25 8" @ 790'

5" @ 3620'

Anhy 1180'

Heeb 3230'

Lans 3271'

Arb 3615'

Perf 15/3477-82

" 34/3465-74, no shows

Sqz off

Used 1500 gals acid @ 3446-56

P 37 BOPD

TD 3630'

~~D&A~~

~~ABANDONED~~

COMPLETED

Map No. _____ Sec. 11 Twp. 13 R. 17W

Well No. 2 Anderson "C"

_____ Cities Service _____ Company

_____ Holmes _____ Contractor

NW SW NW

FIRST REPORT
SECTION PLAT

_____ Ft. from N. Line

990 Ft. from S. Line

_____ Ft. from E. Line

330 Ft. from W. Line

o			

Ellis County

Location _____

Rig up _____

Drilling and Remarks:

drlg. 1190

RECORD

Cased _____ in., _____ ft.

Sand _____

Gas _____

Oil _____

Total Depth _____

PRODUCTION

1st 24 hrs. Nat. _____

1st 24 hrs. after shot _____

Gas _____ Cu. Ft.

Dry Hole _____

Abandoned _____

Date

NOV 23 1949

19

S. J. LEWIS

Scout

Kansas

Map No. _____ Sec. 11 Twp. 13 R. 17W

Well No. 2 Anderson "C"

Cities Service Company

Contractor

NW SW NW

E1 2014
SECTION PLAT

COMPLETE			
o			

_____ Ft. from N. Line

990 Ft. from S. Line

_____ Ft. from E. Line

330 Ft. from W. Line

Ellis County

RECORD

Location _____

Cased _____ in., _____ ft.

Rig up _____

Sand _____

Drilling and Remarks:

Gas _____

Oil _____

Total Depth 3630

8" @ 790

5" @ 3620

ank 1180

Neib 3230

Lans 3271

ank 3615

PRODUCTION

1st 24 hrs. Nat. _____

1st 24 hrs. after shot _____

Gas _____ Cu. Ft.

Dry Hole _____

Abandoned _____

(over)

Date

JAN 25 1950

J. E. TYRA

Scout

720314

Perf - 15/3477-82

34/3465-74 - No Shows

593.078

~~Perf 39~~

used 1500 gals acid @

3446-56

P-37 B.O.P.D.

ç

RECORD

Scout Cards _____

Land Small _____

Land Wall _____

Tracing _____

France Map _____

Pierce Map _____

Misc. _____

JAN 30 1950

[Handwritten signature]