


FORM 51 25M 3-49 PETROL Ellis

Section 11 Township 13 Range 17W

Well No. #2 Dreiling

Company Anderson & Prichard

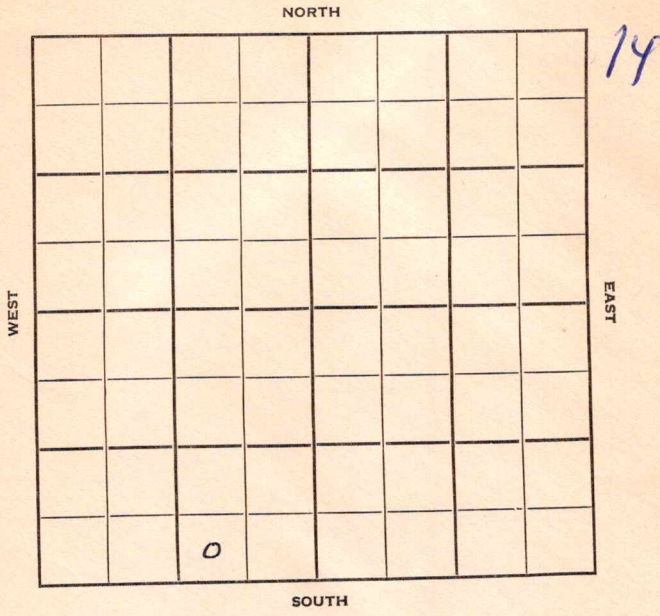

Ellis

KANSAS

Sec. 11 Twp. 13 R. 17W

Well No. #2 Dreiling Farm

Anderson & Prichard Company

Contractor


Ft. from N. Line

330' Ft. from S. Line

990' Ft. from E. Line

Ft. from W. Line

SW SE SW

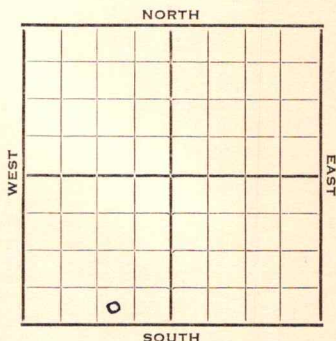

1952

Elev. 2025' REPORT

2/13

Location

2/20

RUR

3/5

Spd 2-18-52

D&A TD 3638

8" @ 242

Anhy 1205 Heeb. 3250

Lans. 3297

DST 3314-41 opn $\frac{1}{2}$ hr

Rec. 630' sw

DST 3447-67 opn $\frac{1}{2}$ hr.

Rec. 3'mud Arb. 3588-3638 TD

D&A

ABANDONED

County **Ellis** State **Kansas**

Sec. **11** (Blk.) **13** (Sur.) **17W** Map No.

Operator Anderson & Prichard

Well No. 2 Farm Dreiling

Elev.	Location	SW	SE	SW
-------	----------	----	----	----

330 Ft. From S Line SW

990	Ft. From	E	Line	Quarter
-----	----------	---	------	---------

1st. Report FEB 13 1952

Completion

Remarks

Spudding Date _____

Drlg. Data

Location

J. G. McGEHEE

(Blk.)
(Twp.)

Anderson-Prichard

2

2025

ABANDONED

330 Ft. From S Line SW

990 Ft. From E Line Quarter

1st. Report

Completion MAR 5 1952

Remarks

Spudding Date 2-18-52

Drlg. Data D & A

8" @ 242 Anhy 1205 Heeb. 3250

Lans. 3297 DST 3314-41 open $\frac{1}{2}$ hr.

Rec. 630' sw DST 3447-67 open $\frac{1}{2}$ hr.

Rec. 3' mud Arb. 3588-3638 TD

D & A

[illegible]