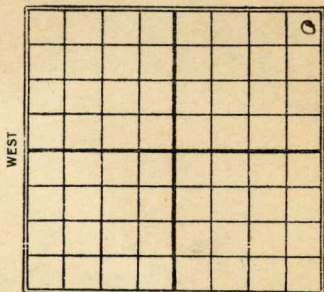


Russell

Map No. 15 Sec. 19 Twp. 12 R. 15 W.Well No. 1 - Ginther Farm
Wilcot Oil & Gas Company

NORTH

300 Ft. from N. Line

Ft. from S. Line

300 Ft. from E. Line

Ft. from W. Line

1926

Date

REPORT

12/1	Rig
12/8	Spud
12/15	—
12/21	—
12/29	Spud 250
1927	
1/5	Drlg 700
1/12	" 918
1/19	" 1537
1/26	" 2120
2/2	2 1/2 m gas @ 2440 UR. 8"
2/9	T. D. 2480 - UR. 8"
2/16	T. D. 2480 - mudding off gas
2/23	Drlg 2490
3/2	" 2678
3/9	" 2730
3/16	" 2975
3/23	Top sand 2993 Oil 3015
	T. D. 3021 - pumped
	60 bbls 24 hrs

Map No. KANSAS Sec. 19 Twp. 12 R. 15WWell No. 1 GinterWilcox Oil & Gas Company

Contractor

SECTION PLAT

300 Ft. from N. Line

----- Ft. from S. Line

300 Ft. from E. Line

----- Ft. from W. Line

			0

FIRST REPORTS

Location -----

Rig up -----

Drilling and Remarks:

Rig

RECORD

Cased ----- in., ----- ft.

Sand -----

Gas -----

Oil -----

Total Depth -----

PRODUCTION

1st 24 hrs. Nat. -----

1st 24 hrs. after shot -----

Gas ----- Cu. Ft.

Dry Hole -----

Abandoned -----

Date

DEC 1 - 1926

S. J. LEWIS

----- 192 ----- Scout

Map No. KANSAS Sec. 19 Twp. 12 R. 15W

Well No. 1 Guither

Wilcox Oil & Gas Company

Contractor

SECTION PLAT

300 Ft. from N. Line

_____ Ft. from S. Line

300 Ft. from E. Line

_____ Ft. from W. Line

			0

COMPLETED

Location _____

Rig up _____

Drilling and Remarks:

T.S. 2993

Oil 3015

T.D. 3021

Pumped 6088 lb

24 hrs.

RECORD

Cased _____ in., _____ ft.

Sand _____

Gas _____

Oil _____

Total Depth _____

PRODUCTION

1st 24 hrs. Nat. _____

1st 24 hrs. after shot _____

Gas _____ Cu. Ft.

Dry Hole _____

Abandoned _____

Date

MAR 23 1927

S. J. LEWIS

192

Scout