


Section 11 Township 13 Range 17W

Well No. 1 Karlin

Company K&E Drlg.

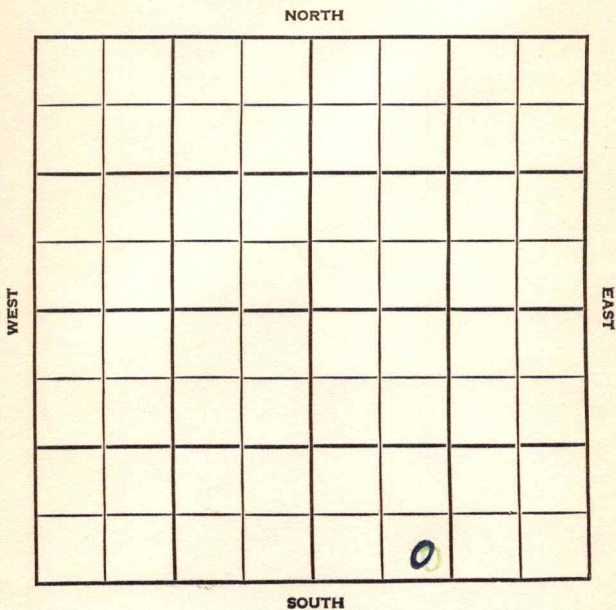

Ellis

KANSAS


|      |      |     |
|------|------|-----|
| SEC. | TWP. | R.  |
| 11   | 13   | 17W |

WELL NO. 1 Karlin FARM

COMPANY K & E Drlg Co.

CONTRACTOR Co. Tools Karlin KANS

\_\_\_\_\_ Ft. from N. Line  
 \_\_\_\_\_ Ft. from S. Line  
 \_\_\_\_\_ Ft. from E. Line  
 \_\_\_\_\_ Ft. from W. Line

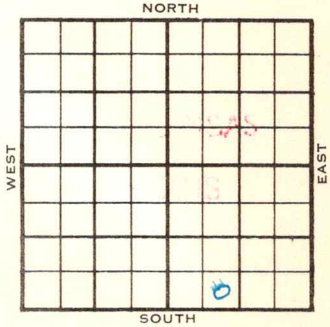

~~SW~~ SE SW SE

|      |           |        |
|------|-----------|--------|
| 1955 | ELEVATION | REPORT |
|      | 2019'     |        |

6/29 Comm 6-27-55  
 7/13 Comm. 6-27-55  
 8-5/8" @ 130/80  
 DST 3310-27 open 1 hr rec 5' mud 55#  
 DST 3336-93 open 1 hr rec 10' SOCM, 140' SW. 700/20"  
 D & A  
 Tops: Depth  
 Anh 1190  
 Tp 2986'  
 H 3246'  
 Tr. 3267'  
 L. 3293'  
 BKC ~~32~~ 3487  
 C. 3549'  
 A. 3579'  
 TD 3607' D & A

**ABANDONED**

County Ellis Elev. 2019  
 Sec. 11 Twp. 13 Rge. 17W  
 Company K & E Drig.  
 Farm Name Karlin No. 1

| TOPS   | DEPTH | LOG | DATUM |
|--------|-------|-----|-------|
| Anh.   |       |     |       |
| Tp.    |       |     |       |
| H.     |       |     |       |
| Tr.    |       |     |       |
| Dg.    |       |     |       |
| Bl.    |       |     |       |
| L.     |       |     |       |
| K.C.   |       |     |       |
| B.K.C. |       |     |       |
| Ce.    |       |     |       |
| C.     |       |     |       |
| M.     |       |     |       |
| M.     |       |     |       |
| K.     |       |     |       |
| Mz.    |       |     |       |
| Me.    |       |     |       |
| V.     |       |     |       |
| S.     |       |     |       |
| S.     |       |     |       |
| A.     |       |     |       |
| R.     |       |     |       |
| PE.    |       |     |       |
| G.     |       |     |       |
| T.D.   |       |     |       |

Loc. in Sec.

**SE SW SE**

Geol.

Contr.

**Co. tools**

Pool

**Karlin**

**FIRST REPORT**  
 JUN 29 '55

Date Comm. 6-27-55

*Handwritten red scribbles*

Co.

Lse.

No.

Sec.

T.

R.

