


Section 19 Township 12 Range 15W

Well No. #3 Beckert #1 Gunther

Company B. & R. Drlg.

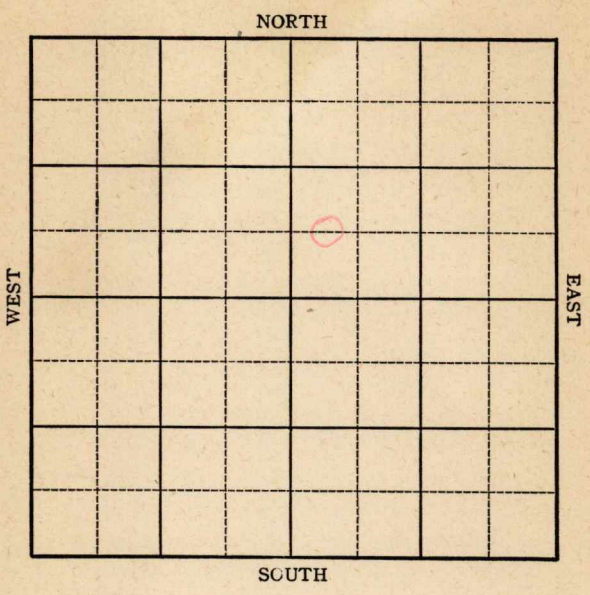

KANSAS Russell County

Sec. 19 Twp. 12 R. 15W

Well No. ~~#3 Beckett~~ #1 Gunther Farm
B & R. Drlg. _____ Company

Fairport

_____ Ft. from N. Line


660

_____ Ft. from S. Line

_____ Ft. from E. Line

330

_____ Ft. from W. Line

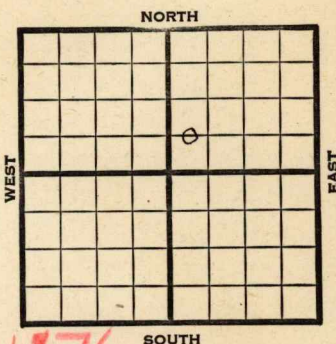

CWL SW NE

Olw. 1876

1945

REPORT

3/28	Location	
4/5	Moving in tools	
4/12	10" @ 127	
	Ank 950	
	Drlg. 2580	
4/20	Drlg. 3295	
4/27	Topeka	2738
	Lans	3020
	BKC	3295
	Cong	3308
	Sand	3322
	TD 3350	
	7" @ 3106' RUST	
5/3	" " " " "	
5/10	" " " " "	
5/17	36 shots 3042 $\frac{1}{2}$ -3046 $\frac{1}{2}$ 2000 acid.	
	48 shots 3017-3025 2000 acid.	
	Squeeze.	
	Perf. 3017-3025 WOC	
5/24	" " " " " " " "	
5/31	" " " " " " " "	
6/13	Sooy	3322
	7" @ 3106'	
	Lams	3020
	Perf Lams	
	2000 acid	
	Pump 25 Pot	
	39 O Gr	
	TD 3355'	

COMPLETED

Pool Name Fairport

Map No. 72 Sec. 19 Twp. 12 R. 15W

Well No. 3 Beckert Gunther 1-1665/DNL

B. & R. Drlg. Company

FIRST REPORT

Contractor

C W L SW NE

SECTION PLAT

 Ft. from N. Line

660 Ft. from S. Line

 Ft. from E. Line

330 Ft. from W. Line

		o	

Russell

Location X

Rig up

Drilling and Remarks:

RECORD

Cased in., ft.

Sand

Gas

Oil

Total Depth

PRODUCTION

1st 24 hrs. Nat.

1st 24 hrs. after shot

Gas Cu. Ft.

Dry Hole

Abandoned

Date

MAR 28 1945 19

S. J. LEWIS Scout

Pool Name Fairport

Map No. 72 Sec. 19 Twp. 12 R. 15W

Well No. 1 Gunther

B & R Drlg. Company

CORRECTION Contractor

C W L SW NE

SECTION PLAT

 Ft. from N. Line

660 Ft. from S. Line

 Ft. from E. Line

330 Ft. from W. Line

		D	

Russell

Location

Rig up

Drilling and Remarks:
reported
#3 Beckert

RECORD

Cased in., ft.

Sand

Gas

Oil

Total Depth

PRODUCTION

1st 24 hrs. Nat.

1st 24 hrs. after shot

Gas Cu. Ft.

Dry Hole

Abandoned

Date

APR 11 1945 19

S. J. LEWIS Scout

~~Dallas~~ Pool Name Fairport

Map No. 72 Sec. 19 Twp. 12 R. 15W

Well No. #1 Gunther

B & R Drlg. Company

COMPLETED Contractor

C W L SW NE

E. 1876
SECTION PLAT

 Ft. from N. Line
660 Ft. from S. Line
 Ft. from E. Line
330 Ft. from W. Line

		o	

Russell County

Location _____

Rig up _____

Drilling and Remarks:

Sooty 3322
7" @ 3106
Liams 3020
Prof Lams.
2000 acid
Pump 25 B/D
39° G

RECORD

Cased _____ in., _____ ft.
Sand _____
Gas _____
Oil _____
Total Depth 3355

PRODUCTION

1st 24 hrs. Nat. _____
1st 24 hrs. after shot _____
Gas _____ Cu. Ft.
Dry Hole _____
Abandoned _____

Date

JUN 1 3 1945 19

S. J. LEWIS

Scout