


Russell

Map No. KANSAS Sec. 19 Twp. 12 R. 15W

Well No. 1- Ruff Farm _____
Central Pit Company _____

_____ Ft. from N. Line
330 Ft. from S. Line
330 Ft. from E. Line
_____ Ft. from W. Line

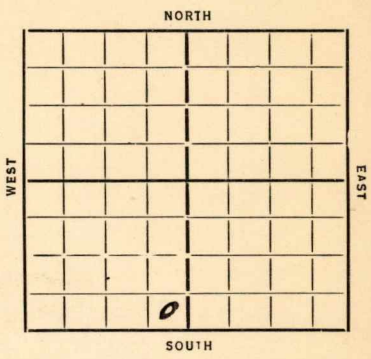

Elev. 1905

Date	REPORT
7/9/35	
6/12	Rgw
6/20	dly 155 20" 70
6/28	" 545
7/3	" 1095 10" 950
7/11	" 1375 8" 1276
7/18	" 1895
7/26	8" 2390 WR 8"
	Sho. Gas 2425
	AY 2455 AY 2495
8/8	Topeka 2730
	Pay 2939-49 T 7 2967
	Swab 3 Bbls per hr.
8/15	2000 acid
	599 Bbls 24 hrs.
8/22	_____
8/29	Oswald 3097 T 7 3222
9/6	2000 acid
9/25	Oswald 3097 T 7 3222
	2000 acid
	856 Bbls.

COMPLETED

Map No. 872 Sec. 19 Twp. 12 R. 15W

Well No. 1- Ruff

Central pet. Company

Contractor

FIRST REPORTS

SECTION PLAT

.....Ft. from N. Line

330 Ft. from S. Line

330 Ft. from E. Line

.....Ft. from W. Line

Location.....

Rig up.....

Drilling and Remarks:

Ruff

RECORD

Cased.....in.,ft.

Sand.....

Gas.....

Oil.....

Total Depth.....

PRODUCTION

1st 24 hrs. Nat.....

1st 24 hrs. after shot.....

Gas.....Cu. Ft.

Dry Hole.....

Abandoned.....

Date

6-12-35 192

ORVAL MANN SCHRECK

Scout

Map No. 72 Sec. 19 Twp. 12 R. 15W

Well No. 1-Ruff

Central pet Company Contractor

COMPLETED

SECTION PLAT

..... Ft. from N. Line
 330 Ft. from S. Line
 330 Ft. from E. Line
 Ft. from W. Line

Location.....

Rig up.....

Drilling and Remarks:

2000 A.

856 HB

RECORD

Cased..... in. ft.
 Sand Oswald 3007
 Gas.....
 Oil.....
 Total Depth 3222

PRODUCTION

1st 24 hrs. Nat.....
 1st 24 hrs. after shot.....
 Gas..... Cu. Ft.
 Dry Hole.....
 Abandoned.....

Date

9-25-35 192

ORVAL MANNSCHRECK

Scout