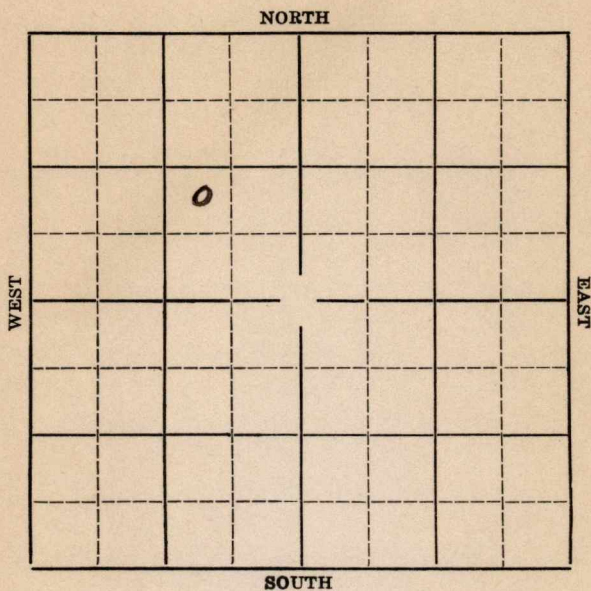



Section 19 Township 12 Range 15-WWell Number #2-GintherCompany Alyward Prod.

Map No. **KANSAS** Sec. 19 Twp. 12 R. 15WWell No. #2 Ginther Farm  
Alyward Prod Company

Ft. from N. Line

990' Ft. from S. Line990' Ft. from E. Line

Ft. from W. Line

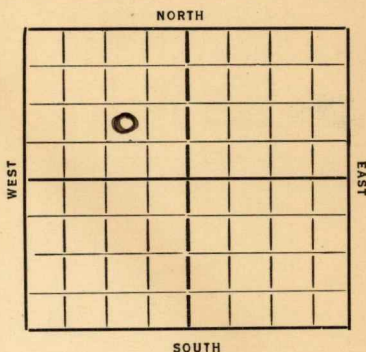**Elev. 1867**Date  
1936

## REPORT

7/22 Rig on ground.7/30 Rigging up.8/6 12" @ 601'. Drlg. 602'.8/13 Drlg. 1500' /8/20 Drlg. 2105'.8/27 Drlg. 2555'.~~8/27x~~9/3 8" @ 2493'. TD 2995'. Run 6".

9/10 **Topeka 2710'. Oswald 3006'**. Show  
oil and water 3096-3110'. P.B. to  
3085'. 1000 gallons acid. Swabb  
115 bbls of oil and 7 bbls of water  
Clean out.

9/18--9/24 Estimated 75 bbls of oil.10/1 Shut down.10/7/36-**Oswald 3006'**.

T.D. 3110'.

P.B. 3085'.

**COMPLETED**

1000 gallons acid.

Pump 25 bbls of oil.

KANSAS

Map No. 72 Sec. 19 Twp. 12 R. 15W

Well No. 2 Ginter

Alward Prod. Company

Contractor

SECTION PLAT

|  |   |  |  |
|--|---|--|--|
|  |   |  |  |
|  | 0 |  |  |
|  |   |  |  |
|  |   |  |  |

\_\_\_\_\_ Ft. from N. Line

990 Ft. from S. Line

990 Ft. from E. Line

\_\_\_\_\_ Ft. from W. Line

FIRST REPORT

Location \_\_\_\_\_

Rig up \_\_\_\_\_

Drilling and Remarks:

ROG

RECORD

Cased \_\_\_\_\_ in., \_\_\_\_\_ ft.

Sand \_\_\_\_\_

Gas \_\_\_\_\_

Oil \_\_\_\_\_

Total Depth \_\_\_\_\_

PRODUCTION

1st 24 hrs. Nat. \_\_\_\_\_

1st 24 hrs. after shot \_\_\_\_\_

Gas \_\_\_\_\_ Cu. Ft.

Dry Hole \_\_\_\_\_

Abandoned \_\_\_\_\_

Date

JUL 22 1936 19

S. J. LEWIS Scout

KANSAS

Map No. 72 Sec. 19 Twp. 12 R. 15WWell No. 2 GinterAlward Production Company

Contractor

## SECTION PLAT

|  |   |  |  |
|--|---|--|--|
|  |   |  |  |
|  | 0 |  |  |
|  |   |  |  |
|  |   |  |  |

Ft. from N. Line

990 Ft. from S. Line990 Ft. from E. Line

Ft. from W. Line

COMPLETED

Location \_\_\_\_\_

Rig up \_\_\_\_\_

Drilling and Remarks:

Oswald 3006PB 30851000 acidPump 25 ft.

## RECORD

Cased \_\_\_\_\_ in., \_\_\_\_\_ ft.

Sand \_\_\_\_\_

Gas \_\_\_\_\_

Oil \_\_\_\_\_

Total Depth 3110

## PRODUCTION

1st 24 hrs. Nat. \_\_\_\_\_

1st 24 hrs. after shot \_\_\_\_\_

Gas \_\_\_\_\_ Cu. Ft.

Dry Hole \_\_\_\_\_

Abandoned \_\_\_\_\_

Date

OCT 7 1936 19S. J. LEWIS Scout