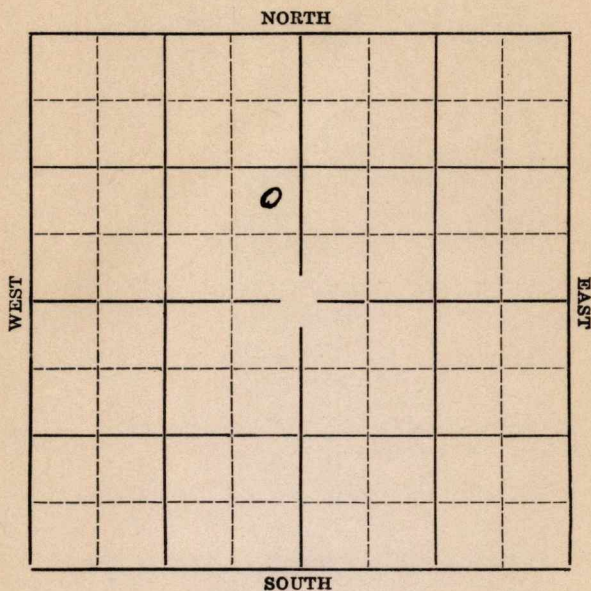


Section 19 Township 12 Range 15-WWell Number 2-GintherCompany Texas Co.

Map No. **KANSAS** Sec. **19** Twp. **12** R. **15W**

Well No. **#2 Ginther** Farm

Texas Oil. Company


Ft. from N. Line

990' Ft. from S. Line

330' Ft. from E. Line

Ft. from W. Line

Elev. 1840

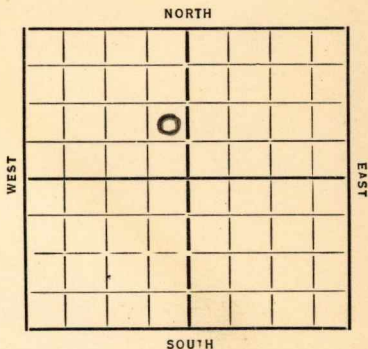

Date **1936**

REPORT

5/6 Location.

5/14 Cellar.

5/21 Rig.

5/28 Drlg. 185'.

6/4 Drlg. 650'.

6/11 Drlg. 1525'. 10" @ 909'.

6/18 Drlg. 2250'.

6/25 Drlg. 2285' fishing tools.

7/2 S.G. 2435'. 8" @ 2450'. Drlg. 2460'.

7/9 6" @ 2685'. Show oil 2715-25'.

Drlg. 2755'.

7/16 **K.C. 2963'**. T.D. 3027'. 1000 gallon
of acid. Pump 180 bbls of oil in
12 hours.

7/22/36-K.C.L. 2963'.

T.D. 3027'.

1000 gallons of acid.

433 bbls of oil potential.

COMPLETED

KANSAS

Map No. 72 Sec. 19 Twp. 12 R. 15NWell No. 2 GinterTexas Oil Company

Contractor

SECTION PLAT

Ft. from N. Line

990 Ft. from S. Line330 Ft. from E. Line

Ft. from W. Line

FIRST REPORT

Location ✓

Rig up

Drilling and Remarks:

RECORD

Cased.....in.,ft.

Sand.....

Gas.....

Oil.....

Total Depth.....

PRODUCTION

1st 24 hrs. Nat.....

1st 24 hrs. after shot.....

Gas.....Cu. Ft.

Dry Hole.....

Abandoned.....

Date

MAY 6 1936

192

S. J. LEWIS

Scout

KANSASMap No. 72 Sec. 19 Twp. 12 R. 15WWell No. 2 LinthosTexas.

Company

Contractor

SECTION PLAT

	0		

_____ Ft. from N. Line

990 Ft. from S. Line330 Ft. from E. Line

_____ Ft. from W. Line

COMPLETED

Location _____

Rig up _____

Drilling and Remarks:

KCL 29631000 acidPost 433 8/16**RECORD**

Cased _____ in., _____ ft.

Sand _____

Gas _____

Oil _____

Total Depth 3027**PRODUCTION**

1st 24 hrs. Nat. _____

1st 24 hrs. after shot _____

Gas _____ Cu. Ft.

Dry Hole _____

Abandoned _____

Date

JUL 22 1936

19

S. J. LEWIS

Scout