


Section 10 Township 17 Range 13-W

Well No. ~~#3~~ ^{#2} Ford "A"

Company Nadel and Gussman

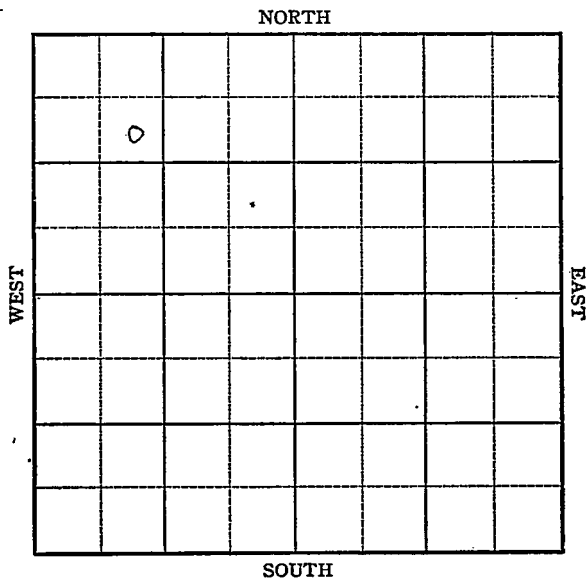

KANSAS

Barton County

Sec. 10 Twp. 17 R. 13W

Well No. #2 Ford "a"
#3 Ford Farm

Nadel & Gussman Company

Susank


NORTH

990 Ft. from N. Line

Ft. from S. Line

Ft. from E. Line

990 Ft. from W. Line

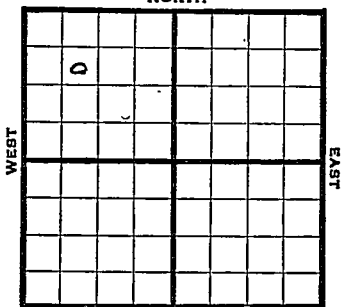

SOUTH

SE NW NW

1946

1401

REPORT

9/18	Location		
9/24	"		
10/1	"		
10/8	8" @ 437 Drlg 1500'		
10/15	Anhy 878' Drlg 3135'		
10/22	Arb 3130' Arb 3352' TD3358 5" @ 3354, RUST		
10/29	" "		
11/6	TD 3359' 1000' oil 12 hrs		
11/12	TD 3361 750 acid, swb 3 oil PH 5 hrs		
11/27	3000 acid, swb 75 oil a day		
12/3	" " "		
12/10	" " "		
12/17	" " "		
1947			
1/4	3000 acid, swb 75 oil a day		
1/8	" " "		
1/15	" " "		

OVER

1947

1/22 Arb 3350'
5" @ 3354'
3750' acid
Pump 75 Pot
TD 3360'
Grav. 36

COMPLETED

KANSAS

Kansas

Pool Name SusankMap No. 73 Sec. 10 Twp. 17 R. 13WWell No. 3 FordNadel & Gussman

Company

FIRST REPORT

Contractor

SE NW NW

SECTION PLAT

990 Ft. from N. Line

_____ Ft. from S. Line

_____ Ft. from E. Line

990 Ft. from W. Line

o			

Barton County

Location X

Rig up _____

Drilling and Remarks:

RECORD

Cased _____ in., _____ ft.

Sand _____

Gas _____

Oil _____

Total Depth _____

PRODUCTION

1st 24 hrs. Nat. _____

1st 24 hrs. after shot _____

Gas _____ Cu. Ft.

Dry Hole _____

Abandoned _____

Date

SEP 1 8 1946 19

S. J. LEWIS

Scout

Susank Post

Map No. 73 Sec. 10 Twp. 17 R. 13W

Well No. 2 Ford "A"

Nadel & Gussman Company

CORRECTION Contractor

SE NW NW

990 Ft. from N. Line

_____ Ft. from S. Line

_____ Ft. from E. Line

990 Ft. from W. Line

SECTION PLAT

o			

Barton County

Location _____

Rig up _____

Drilling and Remarks:

Reported

#3 Ford

RECORD

Cased _____ in., _____ ft.

Sand _____

Gas _____

Oil _____

Total Depth _____

PRODUCTION

1st 24 hrs. Nat. _____

1st 24 hrs. after shot _____

Gas _____ Cu. Ft.

Dry Hole _____

Abandoned _____

Date

NOV 20 1946

19

S. I. LEWIS Scout

KANSAS

Map No. 7.3 Sec. 10 Twp. 17 R. 13W

Well No. 2 Ford "A"

Nadel & Gussman Company

COMPLETE

Contractor

SE NW NW

E11901
SECTION PLAT

990 Ft. from N. Line

 Ft. from S. Line

 Ft. from E. Line

990 Ft. from W. Line

Barton County

Location _____

Rig up _____

Drilling and Remarks:

23858
5" @ 3354
3750 acid
Pump 25 PD

36° Gr

RECORD

Cased _____ in., _____ ft.

Sand _____

Gas _____

Oil _____

Total Depth *3360*

PRODUCTION

1st 24 hrs. Nat. _____

1st 24 hrs. after shot _____

Gas _____ Cu. Ft.

Dry Hole _____

Abandoned _____

Date

JAN 22 1947

19

S. J. LEWIS

Scout