


Section 19 Township 12 Range 15-W

Well Number 2 B. Rusch


Company Central Pet.

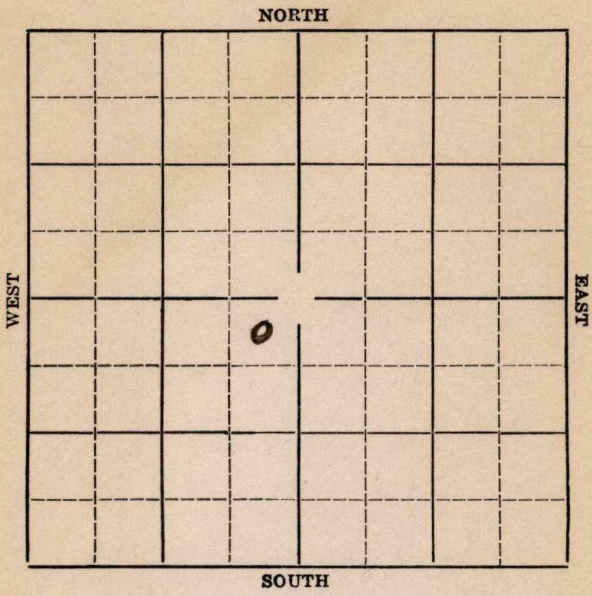

Map No. Sec. 19 Twp. 12 R. 15-W

Well No. 2 B. Rusch Farm
Central Pet. Company

330 Ft. from N. Line
 Ft. from S. Line
330 Ft. from E. Line
 Ft. from W. Line

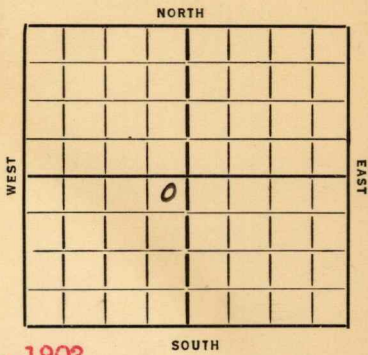

Elev. 1902

Date	REPORT
1936	
4/15	Rig
4/23	Rigging up.
4/30	-- 5/7 --
5/14	10" @ 956'. Drlg. 2050'.
5/21	2474' drlg. 8" @ 2380'.
5/28	2 M. Gas. 2460'. 8" @ 2700'. S.O. 2747-50'. T.D. 2785'. Cleaning out.
6/4	Lansing 3011'. S.D. 3050'. T.D. 3015'. 5000 gallons acid. No test.
6/10/36	- Lansing 3011'. Total depth 3057'. 5000 gallons acid. 545 bbls oil.
	COMPLETED

KANSAS

Russell

Map No. 72 Sec. 19 Twp. 12 R. 15W

Well No. 2 B. Rusch

Central P & O Company

Contractor

SECTION PLAT

	0		

330 Ft. from N. Line

Ft. from S. Line

330 Ft. from E. Line

Ft. from W. Line

FIRST REPORT

Location

Rig up

Drilling and Remarks:

Rig

RECORD

Cased in, ft.

Sand

Gas

Oil

Total Depth

PRODUCTION

1st 24 hrs. Nat.

1st 24 hrs. after shot

Gas Cu. Ft.

Dry Hole

Abandoned

Date

APR 15 1936

192

S. J. LEWIS

Scout

Russell

Map No. ⁷² **KANSAS** Sec. 19 Twp. 12 R. 15W

Well No. 2 Rusch. "B"

Central Pet.

Company

Contractor

SECTION PLAT

330 Ft. from N. Line

_____ Ft. from S. Line

330 Ft. from E. Line

_____ Ft. from W. Line

	0		

COMPLETED

Location _____

Rig up _____

Drilling and Remarks:

*Logging 3011
5000 acid
545 yk.*

RECORD

Cased _____ in., _____ ft.

Sand _____

Gas _____

Oil _____

Total Depth 3057

PRODUCTION

1st 24 hrs. Nat. _____

1st 24 hrs. after shot _____

Gas _____ Cu. Ft.

Dry Hole _____

Abandoned _____

Date

JUN 10 1936 19

S. J. LEWIS

Scout