


KANSAS

Section 19 Township 12 Range 15W

Well Number 3 Rush "A"

Company Central Pet

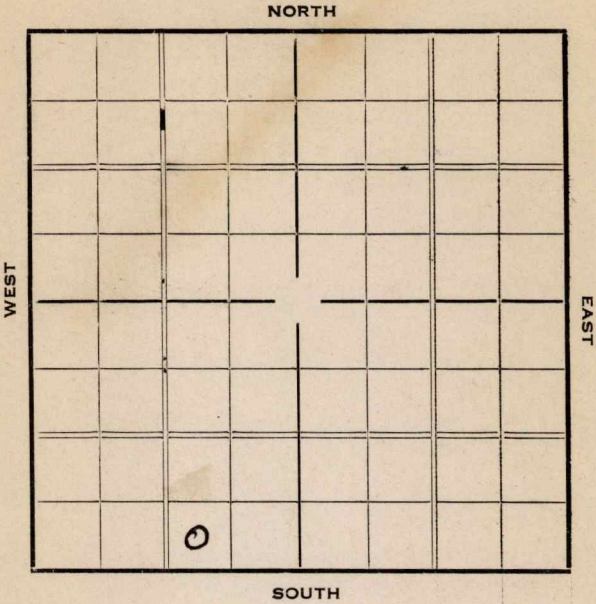

1937

3/17 Lansing 3023'.

T. D. 3080'.

5000 acid.

Potential 646.

COMPLETED

KANSAS

Map No. 72 Sec. 19 Twp. 12 R. 15W

Well No. 3 Rush "A"

Central Pet. Company

Contractor

SECTION PLAT

 Ft. from N. Line

330 Ft. from S. Line

990 Ft. from E. Line

 Ft. from W. Line

FIRST REPORT

Location ✓

Rig up

Drilling and Remarks:

RECORD

Cased in., ft.

Sand

Gas

Oil

Total Depth

PRODUCTION

1st 24 hrs. Nat.

1st 24 hrs. after shot

Gas Cu. Ft.

Dry Hole

Abandoned

Date

NOV 10 1936

19

S. J. LEWIS

Scout

KANSAS *Russell*Map No. *72* Sec. *19* Twp. *12* R. *15W*Well No. *3 Rusch "C"**Central Pet* Company

Contractor

SECTION PLAT

_____ Ft. from N. Line

330 Ft. from S. Line*990* Ft. from E. Line

_____ Ft. from W. Line

COMPLETED

Location _____

Rig up _____

Drilling and Remarks:

*Lansing 3023**5000 acid**Potential**646***RECORD**

Cased _____ in., _____ ft.

Sand _____

Gas _____

Oil _____

Total Depth *3080***PRODUCTION**

1st 24 hrs. Nat. _____

1st 24 hrs. after shot _____

Gas _____ Cu. Ft.

Dry Hole _____

Abandoned _____

Date

MAR 17 1937

19

S. J. LEWIS

Scout