


Section 19 Township 12 Range 15-W

Well Number #3-Rush "B"

Company Central Pet.

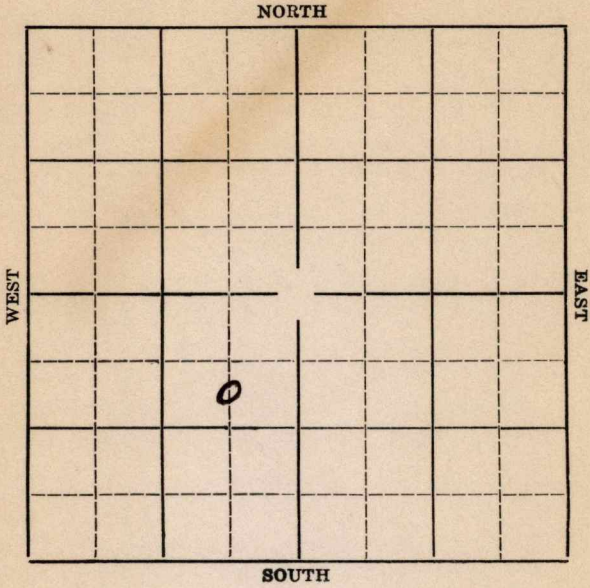

KANSAS

Map No. \_\_\_\_\_ Sec. 19 Twp. 12 R. 15W

Well No. #3 Rush "B" Farm \_\_\_\_\_


Central Pet Company

935' Ft. from N. Line

\_\_\_\_\_ Ft. from S. Line

660' Ft. from E. Line

\_\_\_\_\_ Ft. from W. Line

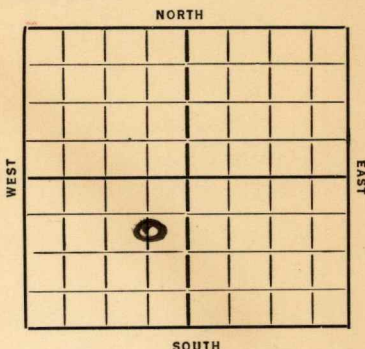

Elev. 1908

Date  
1936

REPORT

7/29 Building rig.

8/6 Spud.

8/13 15" @ 335'. Drlg. 650'.

8/20 Drlg. 1405'. Anhydrate 947'.

8/27 Show gas 2450-65'. Drlg. 2485'.

9/3 8" @ 2700'. Show oil 2752-55'.

T.D. 2785'. Clean out.

9/23/36 - Oswald 2988'.

T.D. 3063'.

Potential 540 bbls of oil nat.

COMPLETED

Map No. 72 Sec. 19 Twp. 12 R. 15W

Well No. 3 Rush "B"

Central P & O Company

Contractor

SECTION PLAT


935 Ft. from N. Line

\_\_\_\_\_ Ft. from S. Line

660 Ft. from E. Line

\_\_\_\_\_ Ft. from W. Line

FIRST REPORT

Location \_\_\_\_\_

Rig up \_\_\_\_\_

Drilling and Remarks:

*Building rig*

RECORD

Cased \_\_\_\_\_ in., \_\_\_\_\_ ft.

Sand \_\_\_\_\_

Gas \_\_\_\_\_

Oil \_\_\_\_\_

Total Depth \_\_\_\_\_

PRODUCTION

1st 24 hrs. Nat. \_\_\_\_\_

1st 24 hrs. after shot \_\_\_\_\_

Gas \_\_\_\_\_ Cu. Ft.

Dry Hole \_\_\_\_\_

Abandoned \_\_\_\_\_

Date

JUL 29 1936 19

S. J. LEWIS Scout

*Russell*

Map No. 72 Sec. 19 Twp. 12 R. 15W

Well No. 3 Rush "B"

Central P. & O. Company

Contractor

SECTION PLAT


935 Ft. from N. Line

\_\_\_\_\_ Ft. from S. Line

660 Ft. from E. Line

\_\_\_\_\_ Ft. from W. Line

COMPLETED

Location \_\_\_\_\_

Rig up \_\_\_\_\_

Drilling and Remarks:

*Oswal 2988.*

*P. & O. 540 P. & O.*

*Nat.*

RECORD

Cased \_\_\_\_\_ in., \_\_\_\_\_ ft.

Sand \_\_\_\_\_

Gas \_\_\_\_\_

Oil \_\_\_\_\_

Total Depth 3063

PRODUCTION

1st 24 hrs. Nat. \_\_\_\_\_

1st 24 hrs. after shot \_\_\_\_\_

Gas \_\_\_\_\_ Cu. Ft.

Dry Hole \_\_\_\_\_

Abandoned \_\_\_\_\_

Date

SEP 23 1936 19

S. J. LEWIS Scout