


Section 12 Township 13 Range 17 W

Well No. # 1 J. J. Lang

Company Lutz et al

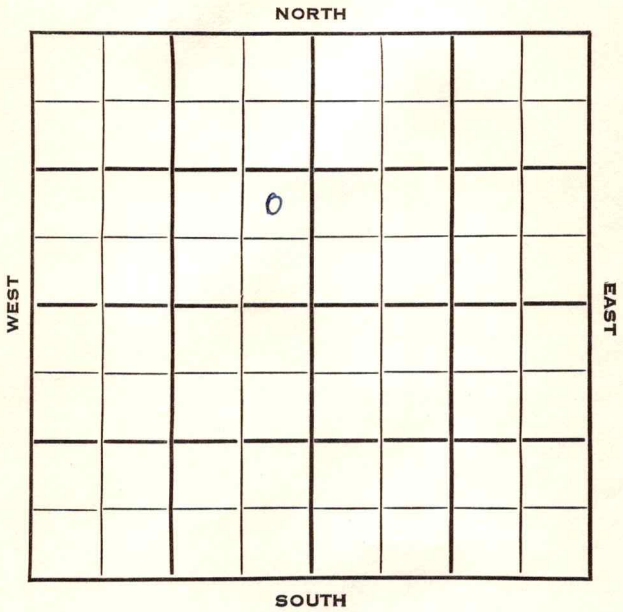

Ellis KANSAS


SEC. 12 TWP. 13 R. 17W ✓

WELL NO. 1 J. J. Lang FARM

COMPANY Lutz et al

CONTRACTOR Nye Wildcat

_____ Ft. from N. Line
 990 _____ Ft. from S. Line
 330 _____ Ft. from E. Line
 _____ Ft. from W. Line

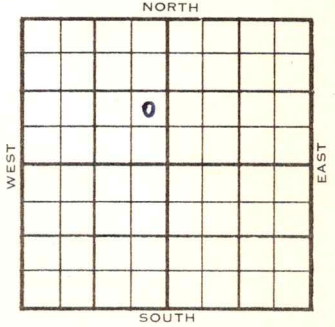

NE SE NW

1954 ELEVATION 2025' REPORT

5/12 Spud 5-6-54
 8" @ 138'
 Drlg. 2514'

5/19 D & A

5/26 Spud 5-6-54
 D&A
 TD 3582'
 8" @ 138'
 Heeb 3260', Mans 3308', Cong. 3563'
 TD 3582'
 D&A

ABANDONED


County **Ellis** State **Kansas**

Sec. **12** (Blk. Twp.) **13** (Sur. Rge.) **17W** Map No.

Operator **Lutz et al.**

Well No. **1** Farm **J. J. Lang**

Elev. **2025** Location **NE SE NW**

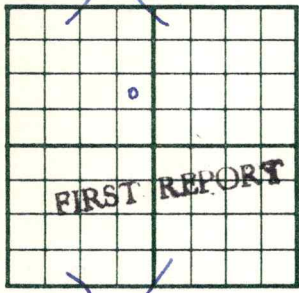

990 Ft. From **S** Line **NW**

330 Ft. From **E** Line Quarter

Ist. Report **MAY 12 1954**

Completion

Remarks **Sunray - IHM**

Nye - Contr.

Spudding Date **5-6-54**

Drlg. Data **Wildcat**

8" @ 138 drlg. 2514

County Ellis State Kansas

Sec. 12 (Blk. 13) (Sur. 17W) (Twp.) 13 (Rge.) 17W Map No.

Operator Lutz etal.

Well No. 1 Farm J. J. Lang

Elev. 2025 Location NE SE NW

ABANDONED

990Ft. From S Line NW

330Ft. From E Line Quarter

1st. Report

Completion **MAY 26 1954**

Remarks Wildcat

Nye - Contr.

Spudding Date 5-6-54

Drlg. Data D & A TD 3582

8" @ 138 Heeb. 3260 Lans. 3308

Cong. 3563 TD 3582

D & A

J. G. McGEHEE