

Q.W.W.O.

Ellis

KANSAS

Section 14 Township 13 Range 17W

Well No. #1 Karlin

Company Sterling Drlg. et al
Fred Nixon

NORTH

WEST

EAST

.							
				o			

SOUTH

7

O.W.W.O. Ellis

KANSAS

Sec. 14 Twp. 13 R. 17W ✓

Well No. #1 Karlin Farm

Sterling Drlg. et al
Fred Nixon

Company

Sterling Drlg. - Contr. Contractor

Wildcat

Ft. from N. Line

990'


Ft. from S. Line

Ft. from E. Line

330'

Ft. from W. Line

NW SW NE

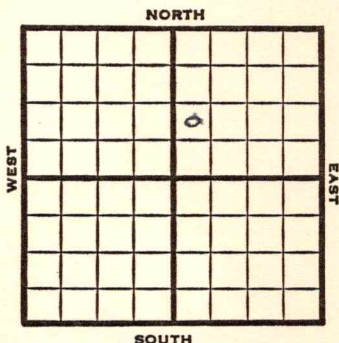

1951

Elev. 2014'

REPORT

1/3

Spud 12-28-50

8" @ 167

Drlg. 1350'

5/2

Spud 12-28-50

Oil well TD 3568' 8" @ 167

Anhy 1185', Top. 2985', Heeb 3231'

Lans. 3276', SO 3343-49', 3359-61'

DST 3343-63 open 15 min. rec 150' OCM

20' free oil SO 3364-68', 3369-73',

3437-41', Arb. 3529' 5" @ 3530

TD 3552' FU 200' oil overnite

500 A DD 3568' FU 400' oil

10 hr. 1000 A FU 620' oil

225' water 15 hr. S/1½ BFPH

SP 3411' 12/3371-75 750 A

S/ 5 BWPB SP 3367' 17/3358-64

water SP 3354' 12/3348-52'

500 A FU 1000' oil 1 hr.

P/ 101 BOPD

P/28 BOPD

2000 A

Comp. 77 BOPD

COMPLETED

11/14

Lans. 3276' O.W.W.O. TD 3568' 5" @ 3530

was Lans. prod. Sq off perf.

CO 3480' 12/3436-40 2500 A

50 BO 7 hr. S/6½ BOPH

OVER

1952

720362

1/2 Oil Well TD 3480
Lans. 3276
5" @ 3530 OTD 3568
CO to 3480 12/ 3436-40 2500A
50 BO 7 hr. S/ $6\frac{1}{2}$ BOPH
S/ 7 BOPH 10 hr.
Comp. 55 BOPD

COMPLETED

County Ellis State KansasSec. 14 (Blk.) 13 (Sur.) 17W Map No.Operator Sterling Drlg. etal.Well No. 1 Farm KarlinElev. 2014 Location NW SW NE

FIRST REPORT

990 Ft. From S Line NE330 Ft. From W Line Quarter1st. Report NOV 14 1951

Completion _____


Remarks OWWO O.W.W.O.

Spudding Date _____

Drlg. Data _____

Lans 3276 T.D. 3568 5" @ 3530 was Lans prod.Sq off perf. Co 3480 12/3436-40 2500A50 Bo 7hr. S/6½ Boph.J. E. TYRA

County Ellis State Kansas
 Sec. 14 (Blk. 13 (Sur. 17W Map No.
 (Twp.) (Rge.)
 Operator Fred Nixon
 Well No. 1 Farm Karlin
 Elev. 2014 Location NW SW NE

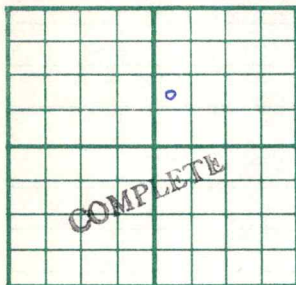

990 Ft. From S Line NE
330 Ft. From W Line Quarter

1st. Report

Completion MAY 2 1951

Remarks Wildcat

Sterling Drlg. - Contr.

Spudding Date 12-28-50

Drlg. Data Oil well TD 3568

8" @ 167 Anhy 1185 Top. 2985

Heeb. 3231 Lans. 3276 SO 3343-49

3359-61 DST 3343-63 open 15 min.

Rec. 150' ocm 20' free oil SO 3364-68

3369-73 3437-41 Arb. 3529 5" @ 3530

TD 3552 FU 200' oil overnite 500 A

DD 3568 FU 400' oil 10 hr. 1000 A

FU 620' oil 225' water 15 hr.

S/ 1½ bfph SP 3411 12/ 3371-75 750 A

S/ 5 bwph SP 3367 17/ 3358-64 water

SP 3354 12/ 3348-52 500 A FU 1000'

oil 1 hr. P/ 101 bopd P/ 28 bopd

2000 A Comp. 77 bopd

J. E. TYRA

County Ellis State KansasSec. 14 (Blk.
Twp.) 13 (Sur.
Rge.) 17W Map No.Operator Sterling Drlg. etal.Well No. 1 Farm KarlinElev. 2014 Location NW SW NE

COMPLETE

990 Ft. From S Line NE330 Ft. From W Line Quarter

1st. Report _____

Completion JAN 2 1952Remarks OWWO

Spudding Date _____

Drlg. Data Oil well TD 3480Lans. 3276 5" @3530 OTD 3568 CO to 348012/ 3436-40 2500 A 50 bo 7 hr.S/ 6½ boph S/ 7 boph 10 hr.Comp. 55 bopd

J. E. TYRA