


Section 20 Township 12 Range 15 W

Well No. #1 J. Mikke

Company Mast Drlg.

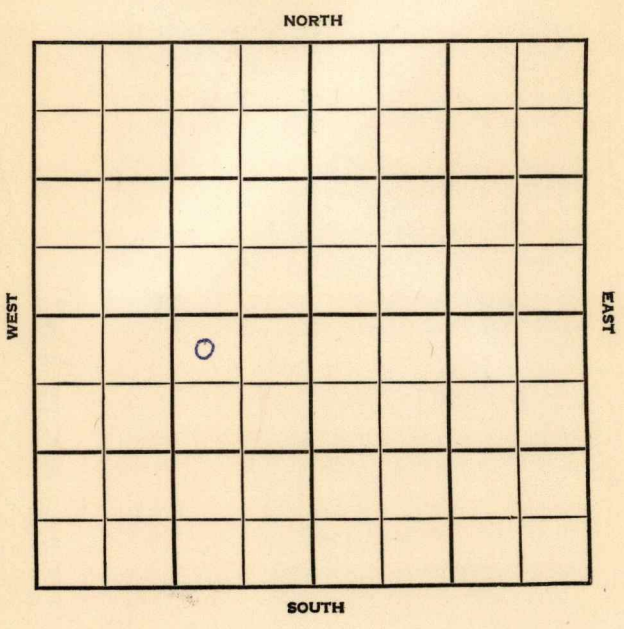

Russell

KANSAS

SEC. 20	TWP. 12	R. 15W
------------	------------	-----------

WELL NO. #1 J. Milke FARM

COMPANY Mast Drlg.

CONTRACTOR Co. Tools


Fairport Ext.

\_\_\_\_\_ Ft. from N. Line

\_\_\_\_\_ Ft. from S. Line

\_\_\_\_\_ Ft. from E. Line

\_\_\_\_\_ Ft. from W. Line

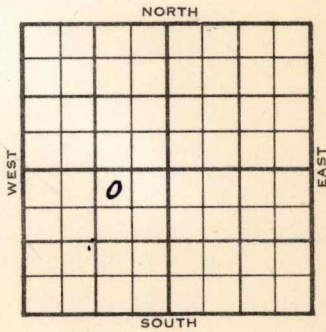

NW NE SW

1956	ELEVATION 1849	REPORT
------	-------------------	--------

3-7  
4-18

RUR  
Comm. 3-5-56  
DST 3001-12 op 1 hr. rec. 190' ho&gcm  
10' wtr. 425/20"  
DST 3027-50 op 1 hr. rec. 120' gas, ~~xxx~~  
10' socm, 50' wtr., 375#  
DST 3072-3100 op 20 min. rec. 210' sw  
510#  
DST 3286-89 op 1 hr. rec. 170' oil, 70'  
hocm, 875#  
5 1/2" @ 3420  
CO to 3320, 6/ 3313-15  
FU 2350' wtr., 12 hrs.,  
PB 3305, 23/ 3298-3303, 10 goph, 500 A  
2 boph,  
PB 3290, 24/ 3284-88, 2 boph, 500 A  
2 1/4 boph,  
PB 3050, 48/ 3002-10, 1500 A  
S/ 10 boph, 12 % wtr.,  
Comp. 25 bopd, 12% wtr.  
H. 2946  
Tr. 2970  
L. 2999  
A. 3284  
TD 3420

COMPLETED



County Russell Elev. 1849  
 Sec. 20 Twp. 12 Rge. 15W  
 Company Mast Drlg.  
 Farm Name J. Milke No. 1

TOPS	DEPTH	LOG	DATUM	Loc. in Sec.																														
Anh.				NW NE SW																														
Tp.																																		
H.	<u>2946</u>																																	
Tr.	<u>2970</u>																																	
Dg.																																		
Bl.																																		
L.	<u>2999</u>		<u>1150</u>	Geol.																														
K.C.				Contr.																														
B.K.C.				Co. tools																														
Ce.				Pool																														
C.				Fairport Ext.																														
M.				<table border="1"> <tr> <td></td> <td></td> <td></td> </tr> <tr> <td></td> <td></td> <td></td> </tr> <tr> <td></td> <td></td> <td></td> </tr> <tr> <td></td> <td></td> <td></td> </tr> <tr> <td></td> <td></td> <td></td> </tr> <tr> <td></td> <td></td> <td></td> </tr> <tr> <td></td> <td></td> <td></td> </tr> <tr> <td></td> <td></td> <td></td> </tr> <tr> <td></td> <td></td> <td></td> </tr> <tr> <td></td> <td></td> <td></td> </tr> </table>																														
M.																																		
K.																																		
Mz.																																		
Ma.																																		
V.																																		
S.																																		
S.																																		
A.	<u>3284</u>		<u>1435</u>																															
R.																																		
Pe.																																		
G.																																		
Tp.	<u>3420</u>																																	

Date Comm. 3-5-56 APR 18 1956

DST 3001-12 open 1 hr. rec. 190' ho  
 & gcm 10' wtr. 425/20" DST 3027-50

open 1 hr. rec. 120' gas 10' socm  
 50' wtr. 375# DST 3072-3100

open 20 min. rec. 210' sw 510#

DST 3286-89 open 1 hr. rec. 170' oil  
 70' hocm 875# 5 1/2" @ 3420 ∞ to 3320

**OVER**

6/ 3313-15 FU 2350' wtr. 12 hr.

PB 3305 23/ 3298-3303 10 goph

500 A 2 boph PB 3290 24/ 3284-88

2 boph 500 A 2 $\frac{1}{2}$  boph PB 3050

48/ 3002-10 1500 A S/ 10 boph 12 $\frac{1}{2}$  wtr.

Comp. 25 bopd 12 $\frac{1}{2}$  wtr.

R. G.

APR 26 1956