

Sec.

Twp.

R

Well No.

Farm

NORTH

WEST

EAST

SOUTH

Location _____

Drilling Remarks:

Rig Up _____

Drilling Remarks:

RECORD

Cased _____ in. _____ ft.

Sand _____

Gas _____

Oil _____

Total Depth_____

PRODUCTION

1st 24 hrs. Nat. _____

1st 24 hrs. after shot

Gas _____ cu. ft.

Dry Hole _____

Abandoned_____

Map No. 15 Sec. 20 Twp. 12 R. 15^W

Well No. 1 Mike Farm


Sutton Hares Estate Company

Ft. from N. Line

200 Ft. from S. Line

1120 Ft. from E. Line

Ft. from W. Line

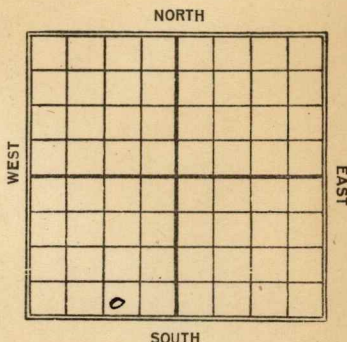

REPORT

Date	REPORT
1/24	Timber. 3600' test
4/24	Sly 1325'
5/10	8" 2222
	Sly 2400
11/23	Sho oil 3070-79
	S. + G. 3617' H.F.W.

Map No. *Mo Map* **KANSAS** Sec. *20* Twp. *12* R. *15W*

Well No. *1 - Milke*

Sutter Haines et al Company

Contractor

FIRST REPORT**SECTION PLAT**

_____ Ft. from N. Line

200 _____ Ft. from S. Line

1120 _____ Ft. from E. Line

_____ Ft. from W. Line

3600' Test

Location _____

Rig up _____

Drilling and Remarks:

Indur

RECORD

Cased _____ in., _____ ft.

Sand _____

Gas _____

Oil _____

Total Depth _____

PRODUCTION

1st 24 hrs. Nat. _____

1st 24 hrs. after shot _____

Gas _____ Cu. Ft.

Dry Hole _____

Abandoned _____

Date

JAN 24 1924

M. A. BENEAR

_____ 192_____

Scou

KANSAS

Russell Co.

Map No. _____ Sec. 20 Twp. 12 R. 15WWell No. 1 milkeSutton & Hawes Company

Contractor

ABANDONED

SECTION PLAT

	0		

_____ Ft. from N. Line

200 Ft. from S. Line1120 Ft. from E. Line

_____ Ft. from W. Line

Location _____

Rig up _____

Drilling and Remarks:

show in 2070-79LOVA 361711.7.11.

RECORD

Cased _____ in., _____ ft.

Sand _____

Gas _____

Oil _____

Total Depth _____

PRODUCTION

1st 24 hrs. Nat. _____

1st 24 hrs. after shot _____

Gas _____ Cu. Ft.

Dry Hole _____

Abandoned _____

Date

NOV 23 1924

M. A. BENEAR

192

Scout