

[illegible]

Rig Up.....

Drilling Remarks

PRODUCTION

1st 24 hrs. Nat.

1st 24 hrs. after shot_____

Gas.....cu. ft.....


Dry Hole.....

Abandoned.....

Russell

Map No. **KANSAS** Sec. 20 Twp. 12 R. 15^w
 Well No. 1- Gibbs Farm
Jae Liggett Company

330 Ft. from N. Line
 _____ Ft. from S. Line
 _____ Ft. from E. Line
330 Ft. from W. Line

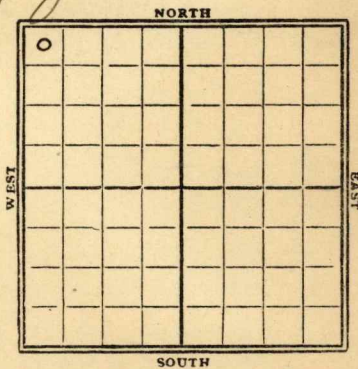

1929

Date	REPORT
5/15	Spud 350'
5/22	Drill 645'
5/29	" 938'
6/5	" 1600'
6/12	" 2085'
6/19	" 2132'
6/26	" 2450'
7/2	Show oil & Gas 2500-10 T.D. 2585'-00
7/10	Top line 2715' T.D. 2720' UIR 8"
7/17	Shy out 2585'
7/24	S.D. 2585'
7/31	Show oil 2900 and at 2965-75
8/7	Top Pay 2981-S.D. sand 2981-3026 T.D. 3026' 108 bbl oil Comp.

Map No. 154 Sec. 20 Twp. 12 R. 15WWell No. 1 G. 154

Company

Contractor

FIRST REPORTS**SECTION PLAT**330 Ft. from N. Line

Ft. from S. Line

Ft. from E. Line

330 Ft. from W. Line

0			

CORRECTION

Location

Rig up

Drilling and Remarks:

RECORD

Cased.....in.,ft.

Sand.....

Gas.....

Oil.....

Total Depth.....

PRODUCTION

1st 24 hrs. Nat.....

1st 24 hrs. after shot.....

Gas.....Cu. Ft.

Dry Hole.....

Abandoned.....

Date

MAY 15 1929

192.....

S. J. LEWIS

Scout

72 **KANSAS** Russell
 Map No. Sec. 20 Twp. 12 R. 15 W

Well No. 1 Sibbs
 Jos. Leggett

Company

Contractor

COMPLETE**SECTION PLAT**

0			

330 Ft. from N. Line

Ft. from S. Line

Ft. from E. Line

330 Ft. from W. Line

Location

Rig up

Drilling and Remarks;

RECORD

Cased _____ in., _____ ft.

Sand 2981-3076

Gas _____

Oil _____

Total Depth 3076

PRODUCTION

1st 24 hrs. Nat. _____

1st 24 hrs. after shot _____

Gas _____ Cu. Ft.

Dry Hole _____

Abandoned _____

Date

AUG 7

1929

CHAS. L. SHERWOOD