


DX 78-1 Russell

**KANSAS**

Section 20 Township 12S Range 15W

Well No. #1 Krug

Company LOUIS Lewis Mai

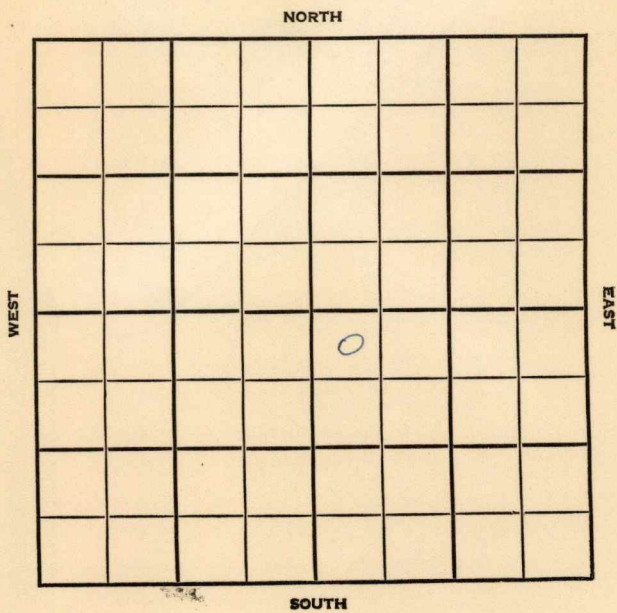

Russell

KANSAS

SEC. 20	TWP. 12	R. 15W
------------	------------	-----------

WELL NO. #1 Krug FARM

COMPANY *Louis Lewis Mai*

CONTRACTOR Mast Drlg.

Fairport

\_\_\_\_\_ FT. FROM N. LINE

\_\_\_\_\_ FT. FROM S. LINE

\_\_\_\_\_ FT. FROM E. LINE

\_\_\_\_\_ FT. FROM W. LINE

NW NW SE

	ELEVATION	REPORT
--	-----------	--------

1956		
8-22	Comm. 8-10-56 8" @ 200 WORT	

Co.

County Russell Elev. 1850 DF.  
 Sec. 20 Twp. 12S Rge. 15W  
 Company Lewis Mai  
 Farm Name Krug No. 1

TOPS	DEPTH	LOG	DATUM	Loc. in Sec.
Anh.	902			NW NW SE
TP.	2824			
H.				
Tr.				
Dg.				
Bl.				
L.	2991			Geol.
K.C.				Contr.
B.K.C.	3216			Mast Drlg.
Ce.				
C.				Pool
M.				Fairport
M.				
K.				
Mz.				
Ma.				
V.				
S.				
S.				
A.	3274			
R.				
PE.				
G.				
T.D.	3300			

Lse.

No.

Sec.

T.

R.

COMPLETE	
SEP 26 '56	

Date Comm. 8-10-56  
8" 200; WORT AUG 29 '56 SEP 5 '56 SEP 12 '56

Ⓜ 2933 DST 2822 - 41 1hr  
 45' 50 spkd Md BHP Fairport  
 DST 2894 - 2934 1hr 30'  
 G.P. rec 30' OCM + 60' WCM  
 BHP 740/20" DST 2997 - 3000  
 1hr 80' oil BHP 400/20"  
 DST 3267 - 80 1hr rec 410' oil +

70' Mdy oil 990/20" 4 1/2

@ 3299 SEP 19 '56 CO SEP 26 '56 CO PF

10/3270-81 FU 1200' oil

12 hrs \$ 7 Boph no/w

9 raw 28° PB 3037 24/

2998-3004 550 1/2 \$

15 To 20 Boph no/w

Pop. P. 25 Boph. no/w

County Russell Elev. \_\_\_\_\_  
 Sec. 20 Twp. 12S Rge. 15W  
 Company Lewis Mai  
 Farm Name Krug No. 1

TOPS	DEPTH	LOG	DATUM
Anh.			
Tp.			
H.			
Tr.			
Dg.			
Bl.			
L.			
K.C.			
B.K.C.			
Ce.			
C.			
M.			
M.			
K.			
Mz.			
Mq.			
V.			
S.			
S.			
A.			
R.			
Pe.			
G.			
T.D.			

Loc. in Sec. NW NW SE  
 Geol. \_\_\_\_\_  
 Contr. Mast Drlg.  
 Pool Fairport

FIRST REPORT  
 AUG 22 '56

Date Comm. 8-10-56  
8" 200; WORT

AUG 29 1956

R. G. R.

Co.

Sec.

No.

Sec.

T.

R.