


Section 14 Township 13 Range 17W

Well No. #2 Karlin

Company Sterling Drlg.

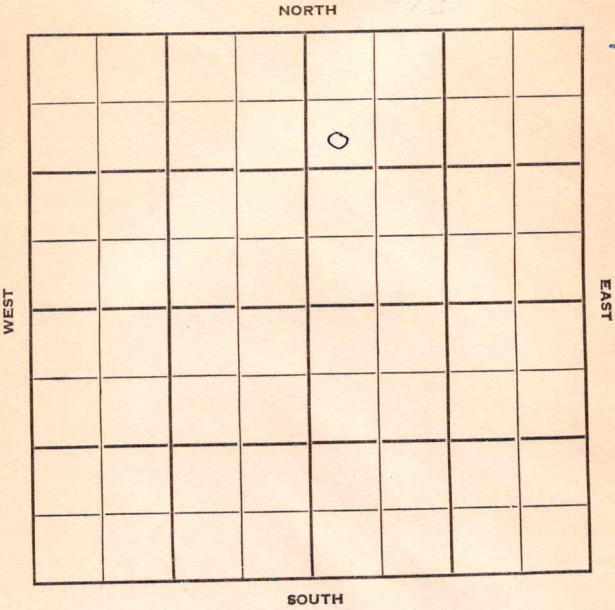

Ellis

KANSAS

Sec. 14 Twp. 13 R. ✓ 17W

Well No. #2 Karlin Farm

Sterling Drlg. Company

Sterling Drlg. - Contr. Contractor


990' Ft. from N. Line

 Ft. from S. Line

 Ft. from E. Line

330' Ft. from W. Line

SW NW NE

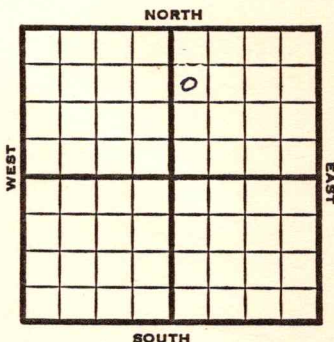

1951 **Elev. 2016'** REPORT

8/22 Spud 8-20-51
8" @ 160
Drlg. 1010

11/21 Spud 8-20-51
Oil Well TD 3553
8" @ 160 **Anhy 1185**
Top 2440 Heeb. 3231
Lans. 3276
DST 3301-10 opn 45 min
Rec. 540' clean oil
BKC 3511 Cong. 3530
Arb. 3542 TD 3550
5" @ 3543 DD 3551
FU 50 go $\frac{1}{2}$ hr DD 3553
S/ $1\frac{1}{2}$ boph 1000 A
S/ $1\frac{1}{2}$ boph SP 3480
12/3445-48 12/3438-44 1000 A
FU 18 bo 8 hr. S/27 bo 3 hr.
P/35 bopd 2500 A Comp. 145 bopd

COMPLETED

J. E. TYR

County Ellis State Kansas

Sec. 14 (Blk.) 13 (Sur.) 17W Map No.

Operator Sterling Drlg.

Well No. 2 Farm Karlin

Elev.	2016	Location	SW NW NE
-------	------	----------	----------

990 Ft. From N Line NE

330 Ft. From W Line Quarter

1st. Report

Completion NOV 21 1951

Remarks

Sterling Drlg. - Contr.

Spudding Date 8-20-51

Drlg. Data Oil well TD 3553

8" @ 160 Anhy 1185 Top. 2440

Heeb. 3231 Lans. 3276 DST 3301-10

open 45 min. Rec. 540' clean oil

B KC 3511 Cong. 3530 Arb. 3542

TD 3550 5" @ 3543 DD 3551 FU 50 go $\frac{1}{8}$ hr

DD 3553 S/ $1\frac{1}{2}$ boph 1000 A S/ $1\frac{1}{2}$ boph

SP 3480 12/ 3445-48 12/ 3438-44 1000 A

FU 18 bo 8 hr. S/ 27 bo 3 hr.

P/ 35 bopd 2500 A Comp. 145 bopd

J. E. TYRA