


KANSAS

Section 14 Township 13 Range 17W

Well No. #3 Karlin

Company Sterling Drlg.

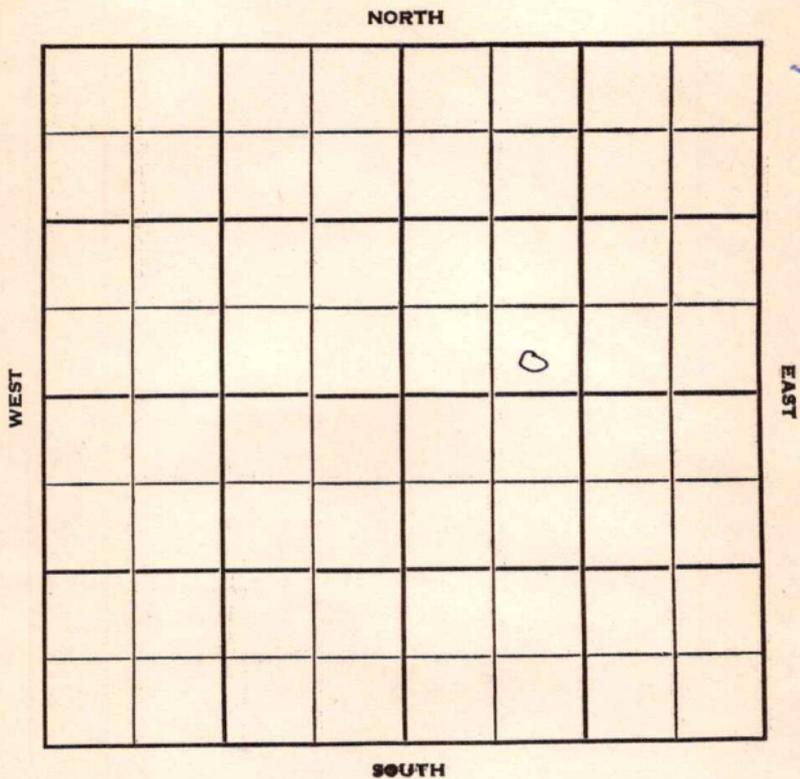

Ellis

KANSAS

Sec. 14 Twp. 13 R. 17W

Well No. #3 Karlin Farm

Sterling Drlg. Company

Karlin Pool Contractor


 Ft. from N. Line

330' Ft. from S. Line

 Ft. from E. Line

990' Ft. from W. Line

SE SW NE

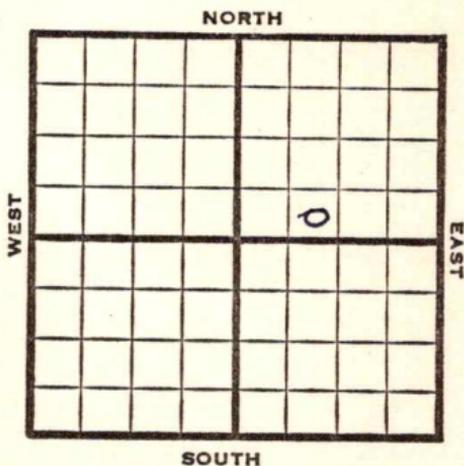

1951

REPORT

Elev. 2012'

9/5

Spud 9-2-51
8" @ 162
WOC

1952
1/9

Spud 9-2-51
Oil well TD 3598' 8" @ 162'
Heeb 3231' Lans. 3277'
DST 3283-3310 open 45 min, rec 330'
HOCM
DST 3310-20 open 45 min, rec 63' mud
& water.
Arb. 3538-41' 5" @ 3539' TD 3598'
29/3437-47 1000 A 2 BOPH
2500 A no inc. PB 3480'
20/3353-58 1000 A no inc. PB 3345'
28/3305-10 1000 A 13 BO 47 BW
PB 3300' 12/3325-29 10 BFPH 90% wtr
12/3302-06 S/40 BO 50 BWPD
Comp. 40 BOPD 60 BW

COMPLETED

County **Ellis** State **Kansas**

Sec. **14** (Blk.) **13** (Sur.) **17W** Map No. (Twp.)

Operator **Sterling Drlg.**

Well No. **3** Farm **Karlin**

Elev. Location **SE SW NE**

FIRST REPORT

330 Ft. From **S** Line **NE**

990 Ft. From **W** Line Quarter

1st. Report **SEP 5 1951**

Completion

Remarks

Spudding Date **9-2-51**

Drlg. Data **Karlin Pool**

8" @ 162 WOC

County Ellis State Kansas

Sec. 14 (Blk. 13) (Sur. 17W) Map No.

Operator Sterling Drlg.

Well No. 3 Farm Karlin

Elev. 2012 Location SE SW NE



330 Ft. From S Line NE

990 Ft. From W Line Quarter

Ist. Report

Completion JAN 9 1952

Remarks Karlin Pool

Spudding Date 9-2-51

Drlg. Data Oil well TD 3598

8" @ 162 Heeb. 3231 Lans. 3277

DST 3283-3310 open 45 min. Rec. 330'

hocm DST 3310-20 open 45 min. Rec.

63' mud & water Arb. 3538-41 5" @ 3539

TD 3598 29/ 3437-47 1000 A 2 boph

2500 A no inc. PB 3480 20/ 3353-58

1000 A no inc. PB 3345 28/ 3305-10

1000 A 13 bo 47 bw PB 3300

12/ 3325-29 10 bfph 90% water

12/ 3302-06 S/ 40 bo 50 bwpd

Comp. 40 bopd 60 bw

J. E. TYRA