

Ellis

KANSAS

Section 14 Township 13 Range 17 W

Well No. # 1 Kuhn

Company Texas

NORTH

11

WEST

			0				

EAST

SOUTH

Ellis

KANSAS

Sec. 14 Twp. 13 R. 17W

Well No. #1 Kuhn Farm

Texas Company

Woffard Contractor

Karlin


330 Ft. from N. Line

\_\_\_\_\_ Ft. from S. Line

330 Ft. from E. Line

\_\_\_\_\_ Ft. from W. Line

NE NE SW

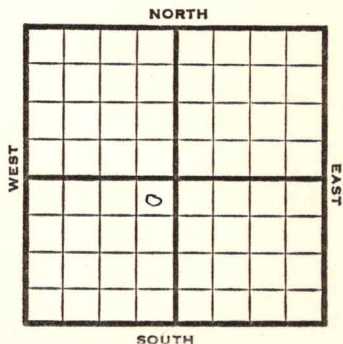

1951

Elev. 2009' REPORT

10/31

Spud 10-23-51  
13" @ 1194'  
Drlg. 1860'

1952  
1/23

Spud 10-23-51  
Oil well TD 3554' 13" @ 1194'  
Heeb 3226' Lans. 3273'  
Arb. 3536' TD 3540' 7" @ 3539'  
TD 3554' S/5 GOPH PB 3448'  
14/3426-30 15/3434-39 S/10 GOPH  
2000 A S/9 BOPH 4 hr. P/63 BO  
16 hr. P/32 BO 5 BW 18 hr.  
Comp. 128 BOPD 5% water.

**COMPLETED**

County Ellis State Kansas

Sec. 14 (Blk. 13 (Sur. 17W (Twp.) (Rge.) Map No.

Operator Texas

Well No. 1 Farm Kuhn

Elev. \_\_\_\_\_ Location NE NE SW

<b>FIRST REPORT</b>																		

330 Ft. From N Line SW

330 Ft. From E Line Quarter

Ist. Report OCT 31 1951

Completion \_\_\_\_\_

Remarks \_\_\_\_\_

Woffard - Contr.

Spudding Date 10-23-51

Drlg. Data Karlin

13" @ 1194 Drlg. 1860

J. E. TYRA


County Ellis State Kansas

Sec. 14 (Blk. 13 (Sur. 17W (Rge.) Map No.

Operator Texas Company

Well No. 1 Farm Kuhn

Elev. 2009 Location NE NE SW

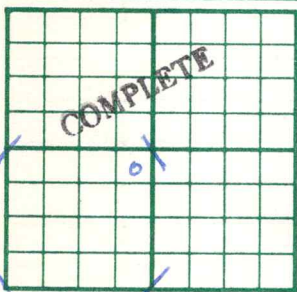

330 Ft. From N Line SW

330 Ft. From E Line Quarter

1st. Report

Completion JAN 23 1952

Remarks Karlin Pool

Woffard - Contr.

Spudding Date 10-23-51

Drlg. Data Oil well TD 3554

13" @ 1194 Heeb. 3226 Lens. 3273

Arb. 3536 TD 3540 7" @ 3539

TD 3554 S/ 5 goph PB 3448

14/ 3426-30 15/ 3434-39 S/ 10 goph

2000 A S/ 9 boph 4 hr. P/ 63 bo

16 hr. P/ 32 bo 5 bw 18 hr.

Comp. 128 bopd 4% water

J. G. McGEHEE