



Ellis

KANSAS

SEC.	TWP.	R.
14	13	17W

WELL NO.

1 Kuhn

FARM

COMPANY

Oil Trading & K & E

CONTRACTOR

K & E Drlg.


Wildcat

\_\_\_\_\_ Ft. from N. Line

\_\_\_\_\_ Ft. from S. Line

\_\_\_\_\_ Ft. from E. Line

\_\_\_\_\_ Ft. from W. Line

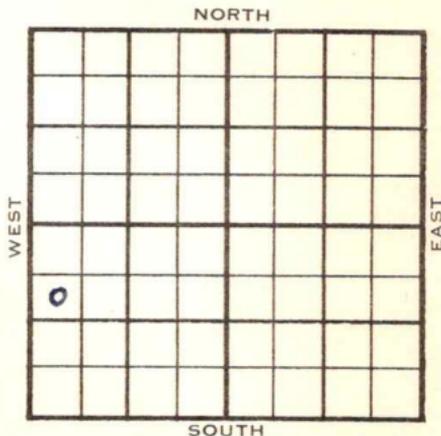

SW NW SW

Texas - FO

ELEVATION

1955

1973 KB, 1970 DF

REPORT

6/15

Comm 6-9-55  
 8" @ 105/75  
 Anh 1143  
 Drlg 2670

8/17

DST 3242-57, open 1 hr. Rec. 420' gas,  
 90' hocm 0/20" DST 3265-3301 open 1 hr.  
 Rec. 170' vhocm 765/20" DST 3456-86 open  
 1 hr. Rec. 180' gas 1925' gassy oil 240  
 hocm 940/20" TD 3486 5 1/2" @ 3478/125 FU  
 700' oil 15 min. FU 2100' oil 1 1/4 hr.  
 S/14 boph 5 hr. Comp 50 bopd  
 Anh: 1143,  
 Tp: 2918, 945,  
 H: 3182, 1209,  
 L: 3226, 1253,  
 BKC: 3458, 1485,  
 C. 3470, 1487,  
 A: 3477, 1504,  
 TD: 3486

COMPLETED

County Ellis Elev. \_\_\_\_\_  
 Sec. 14 Twp. 13 Rge. 17W  
 Company Oil Trading & K & E  
 Farm Name Kuhn No. 1

TOPS	DEPTH	LOG	DATUM	Loc. in Sec.				
Anh.	1143			SW NW SW				
Tr.								
Dg.								
B.L.								
L.				Geol. _____				
K.C.								
B.K.C.				Contr. _____				
Ce.								
C.				K & E drlg.				
M.								
M.				Pool _____				
K.								
Mz.				Wildcat				
Me.								
V.				<table border="1"> <tr> <td colspan="2">FIRST REPORT</td> </tr> <tr> <td>o</td> <td>JUN 15 '55</td> </tr> </table>	FIRST REPORT		o	JUN 15 '55
FIRST REPORT								
o	JUN 15 '55							
S.								
S.								
A.								
R.								
PE.								
G.								
T.D.								

Date Comm. 6-9-55 Texas FO  
8" @ 105/75 drlg. 2670


*K-11*

Co.  
Lse.  
No.  
Sec.  
T.  
R.

County Ellis Elev. 1973 KB  
1970 DF  
 Sec. 14 Twp. 13 Rge. 17W  
 Company Oil Trading & K & E Drlg.  
 Farm Name Kuhn No. 1

TOPS	DEPTH	LOG	DATUM
Anh.	1143		
TP.	2918		945
H.	3182		1209
Tr.	3202		1229
Dg.			
BL.			
L.	3226		1253
K.C.			
B.K.C.		3458	1485
Ce.			
C.		3470	1497
M.			
M.			
K.			
Mz.			
Ma.			
V.			
S.			
S.			
A		3477	1504
R.			
PE.			
G.			
TD.	3486		

Loc. in Sec. SW NW SW  
 Geol. \_\_\_\_\_  
 Contr. K & E Drlg.  
 Pool Karlin

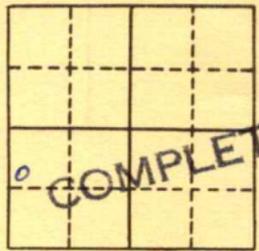

Date Comm. 6-9-55 AUG 17 1955  
8" @ 105/75 DST 3242-57 open 1 hr.  
Rec. 120' gas 90' hocm 0/20"  
DST 3265-3301 open 1 hr. Rec. 170' vho  
765/20" DST 3456-86 open 1 hr.  
Rec. 180' gas 1925' gassy oil 240' hocm  
940/20" TD 3486 5 1/2" @ 3478/125  
FU 700' oil 15 min. FU 2100' oil 1 1/4 hr.

**OVER**

S/ 14 boph 5 hr. Comp. 50 bopd

Scout Cards	.....
Lat. Small Map	.....
Land Wall Map	.....
Tracings	.....
France Map	.....
Pierce Map	.....
Misc.	.....

*[Handwritten signature]*

AUG 25 1958