

Russell

KANSAS


SECTION 20 TOWNSHIP 12S RANGE 15W

WELL NO. #2 Driscol Fee-Fairport

COMPANY Jerry Driscol

NORTH

~~E/2 NE/4~~ NW SE NE

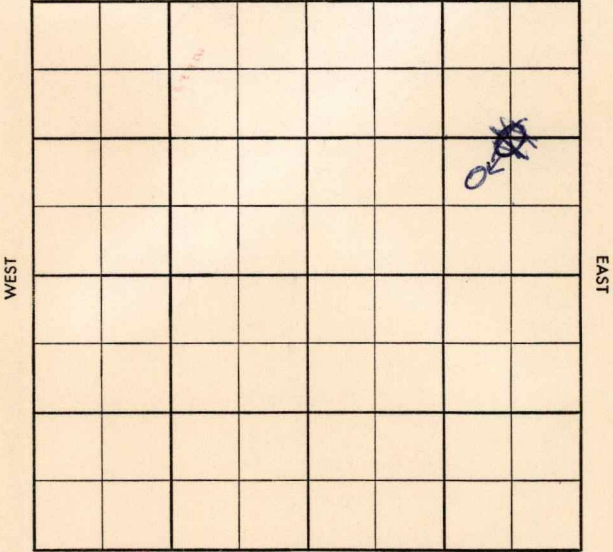

SOUTH



CO. ~~Russell~~ ELEV. \_\_\_\_\_

SEC. ~~20~~ TWP. ~~12~~ RGE. ~~15W~~

COMPANY ~~Jerry Driscol~~ NO. ~~2~~

NOV 27 1957	0
FIRST REPORT	

FARM ~~Driscol Fee - Fairport~~

LOC. ~~E/2 NE/4~~


GEOL. \_\_\_\_\_  
 CONTR. ~~V.D. Sidey tools~~  
 POOL ~~Fairport~~  
 SPUD ~~11/20/57~~  
 8" @ 903?, Drlg. 2110.

CO.

LSE.

NO.

SEC.

TWP.

RGE.

