


SECTION 20 TOWNSHIP 12 RANGE 15W

WELL NO. #2 Krug

COMPANY Louis M. Mai

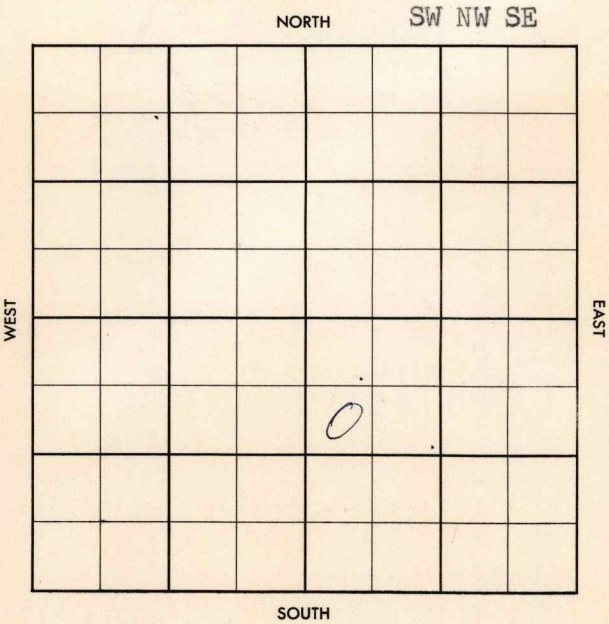

County Russell Elev. 1864  
 Sec. 20 Twp. 12 Rge. 15W  
 Company Louis M. Mai  
 Farm Name King No. 2

TOPS	DEPTH	LOG	DATUM	Loc. in Sec.												
Anh.				SW NW SE												
TP.																
H.																
Tr.																
Dg.																
Bl.																
L.																
K.C.	<u>3009</u>			Geol.												
B.K.C.				Contr.												
Ce.				<u>Wast Drlg.</u>												
C.																
M.				Pool												
M.				<u>Fairport</u>												
K.																
Mz.																
Mo.																
V.																
S.																
S.																
A																
R.	<u>Gorb. 3298</u>			<table border="1"> <tr> <td colspan="4">COMPLETE</td> </tr> <tr> <td colspan="4">JUN 26 '57</td> </tr> <tr> <td></td> <td></td> <td></td> <td>o</td> </tr> </table>	COMPLETE				JUN 26 '57							o
COMPLETE																
JUN 26 '57																
			o													
PE.	<u>A16 3327</u>															
G.																
TD.	<u>3346</u>															

Date Comm. 6-7-57  
3" @ 910/400, Drlg. 1050 JUN 19 57 #3308  
JUN 26 57 5 1/2 3345 Co 3050  
33/3039-43 1 1/2 @ 30 Bopk  
no/w 1000' o.B. est P. 25  
Bopd no/w etc.

County Russell Elev. \_\_\_\_\_  
 Sec. 20 Twp. 12 Rge. 15W  
 Company Louis M. Mai  
 FarmName Krug No. 2

TOPS	DEPTH	LOG	DATUM	Loc. in Sec.
Anh.				SW NW SE
Tp.				
H.				
Tr.				
Dg.				
BL.				
L.				Geol. _____
K.C.				Contr. _____
B.K.C.				
Ce.				Mast Drlg.
C.				
M.				Pool
M.				Fairport
K.				
Mz.				
Me.				
V.				
S.				
S.				
A				
R.				
PE.				
G.				
T.D.				

JUN 12 1957  
 FIRST REPORT  
 O

Date Comm. 6-7-57  
8" @ 910/400, Drlg. 1050

