

20

12


15W

Section _____ Township _____ Range _____

Well No. #2 Milke _____

Company Mai Operations _____

NORTH

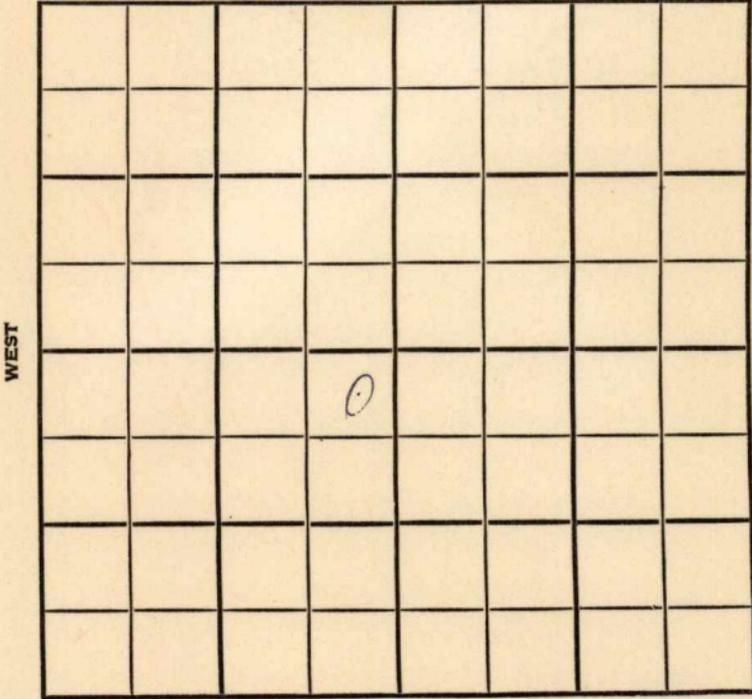

SOUTH

Co.

County Russell Elev. 1868
 Sec. 20 Temp. 12 Rge. 15W
 Company Mai Operations
 Farm Name Milke No. 2

TOPS	DEPTH	LOG	DATUM	Loc. in Sec.
Anh.	925			NE NE SW
TP.	2743			
H.	2963			
Tr.	2986			
Dg.				
Bl.				
L.				
K.C.	3014			Geo. <u>Green</u>
B.K.C.	3283			Contr.
Ce.				<u>Mast Drlg.</u>
C.				
M.				
M.				Pool
K.				<u>Fairport</u>
Mz.				
Mo.				
V.				COMPLETE
S.				
S.				
A.	3309			
R.				
PE.				
G.				
TD.	3342			JAN 2 '57

Loc.

No.

Sec.

T.

R.

Date Comm. 11-22-56

8" @ 931 w/425, Drlg. 1760 DEC 5 '56

DST 3038-47 1 hr @ 135' see 190'

Free oil 410/20" Rng 5 1/2"

DST 3295-3319 1 hr @ 60' SCM

BHP 575/30 Rng 5 1/2 DEC 12 '56

@ 3342 DEC 19 '56 DEC 26 '56 No 11 in

dope. JAN 2 '57 Co 32/3038-46

M P. 50 Bopd not wtr

P. 25 Bopd not wtr

County Russell Elev. _____
 Sec. 20 Twp. 12 Rge. 15W
 Company Mai Operations
 Farm Name Milke No. 2

TOPS	DEPTH	LOG	DATUM	Loc. in Sec.
Anh.	925			NE NE SW
Tp.				
H.				
Tr.				
Dg.				
Bl.				
L.				Green
K.C.				Contr.
B.K.C.				Mast Drlg.
Ce.				
C.				
M.				Pool
M.				
K.				Fairport
Mz.				
Me.				
V.				
S.				
S.				
A.				
R.				
Pc.				
G.				
T.D.				

NOV 28 '56
 FIRST REPORT

Date Comm. 11-22-56
8" @ 931 w/425, Drlg. 1760

