


Section 20 Township 12 Range 15W

Well No. #3 Gibbs

Company R.P. Nixon

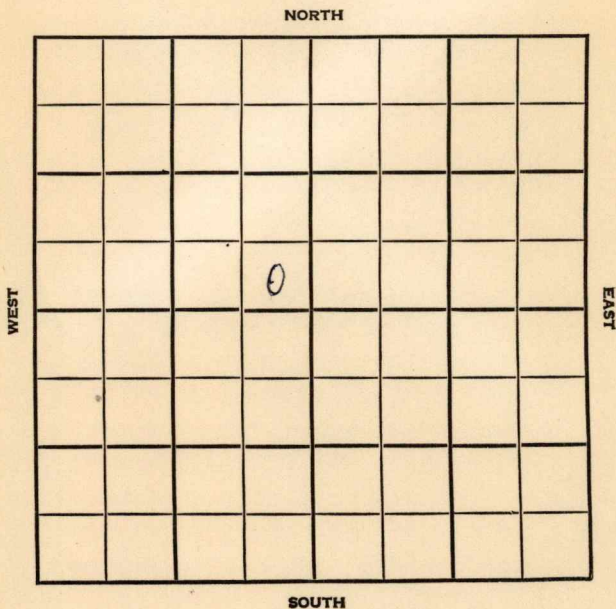

County Russell Elev. _____
 Sec. 20 Twp. 12 Rge. 15W
 Company R. P. Nixon
 Farm Name Gibbs No. 3

Co.

TOPS	DEPTH	LOG	DATUM
Anh.			
Tp.			
H.			
Tr.			
Dg.			
Bl.			
L.			
K.C.			
B.K.C.			
Ce.			
C.			
M.			
M.			
K.			
Mz.			
Me.			
V.			
S.			
S.			
A.			
R.			
P.C.			
G.			
T.D.			

Loc. in Sec. SE SE NW
 Geol. _____
 Contr. Mast Drlg.
 Pool Fairport

NOV 14 1966

 FIRST REPORT

Lse.

No.

Sec.

T.

R.

Date Comm. RUR

NOV 5 9 1966

R. G.

County Russell Elev. 1848
 Sec. 20 Twp. 12 Rge. 15W
 Company R. P. Nixon
 Farm Name Gibbs No. 3

TOPS	DEPTH	LOG	DATUM	Loc. in Sec.
Anh.	899			SE SE NW
Tp.				
H.	2941			
Tr.	2961			
Dg.				
Bl.				
L.	2993			Geol.
K.C.				Contr.
B.K.C.				Mast Drlg.
Ce.				Pool
C.				Fairport
M.				COMPLETE
M.				
K.				DEC 13 '56
Mz.				
Me.				
V.				
S.				
S.				
A.	3296			
R.				
PE.				
G.				
T.D.	3304			

Date Comm. RUR NOV 21 '56 11-14-56 85/8 @
210/200 @ 2965 NOV 28 '56 Pipe set.
DEC 5 '56 DST 3297-3304 1hr. 3' oil
+20' 0.5' GCM + 35' oily MW BHP
1020/20" 9 1/2 @ 3303/225 CO
20/3023-28 ~~12~~ 12-8 55 Bopd
+Tr. wtr. P.d.Y. DEC 12 '56 P. 25
Bopd + Tr. wtr.