

Russell

KANSAS

20


12S

15W

SECTION _____ TOWNSHIP _____ RANGE _____

WELL NO. #3 Krug

COMPANY Mast Drlg.

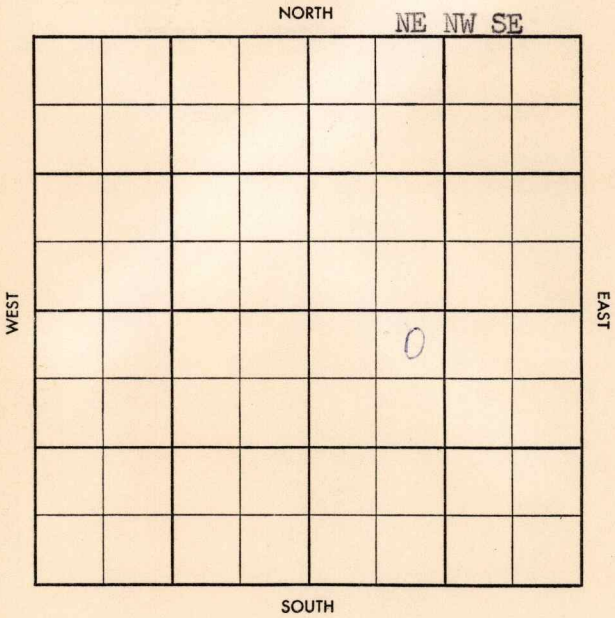

FIRST REPORT

CO. Russell ELEV. _____

SEC. 20 TWP. 12 RGE. 15W

COMPANY Mast Drlg. Co. NO. 3

FARM Krug

LOC. NE NW SE

GEOL. _____

CONTR. _____

POOL Fairport

SPUD 11/18/57

CO.

LSE.

NO.

SEC.

TWP.

RGE.

7

7

CO. ~~Russell~~ ELEV. 18670
SEC. 20 TWP. 12 RGE. 15W
COMPANY Mast Drlg. Co. NO. 3

COMPLETE
DEC 11 57

FARM Krug
LOC. NE NW SE

GEOL.
CONTR.
POOL Fairport
SPUD 11/18/57
A₂ 914
85 924
146 2960TR
2980 Lsg 3011
Ø 3300 DEC 4 57
KC 3013 C 3294

Arb 3310 no DST TD
3316 no log 5 1/2 3313
wact CO 3316 1/2
\$ 35 BW p h + oil PB
3200 16/3093-47 1500 A
\$ 5 1/2 Bop h NW 8 hrs pop
est 25 Bop d NW
Lsg 3043-47

CO
LSE.
NO.
SEC.
TWP.
RGE.