

Russell

KANSAS

20

12

15W


SECTION \_\_\_\_\_ TOWNSHIP \_\_\_\_\_ RANGE \_\_\_\_\_

#3 Milke

WELL NO. \_\_\_\_\_

Louis Mai

COMPANY \_\_\_\_\_

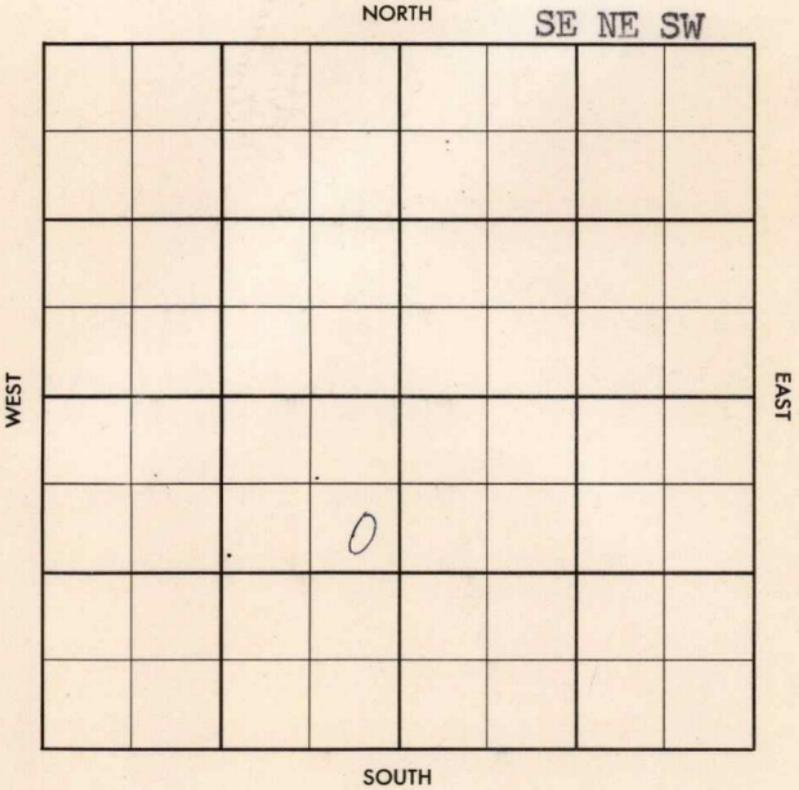



County Russell Elev. 1878  
 Sec. 20 Twp. 12 Rge. 15W  
 Company Louis Mai  
 Farm Name Milke No. 3

Co.  
Lse.  
No.  
Sec.  
T.  
R.

TOPS	DEPTH	LOG	DATUM
Anh.	926		
Tr.	<del>1000</del>		
H.	TP 2752		
Tr.	H6 2971		
Dg.			
Bl.			
L.	3021		
K.C.			
B.K.C.	3287		
Ce.			
C.			
M.			
M.			
K.			
Mz.			
Ma.			
V.			
S.			
S.			
A.	3311		
R.			
Pe.			
G.			
TD.	3360		

Loc. in Sec. SE NE SW  
 Geol. \_\_\_\_\_  
 Cont. Mast Drlg.  
 Pool \_\_\_\_\_  
Fairport  
**COMPLETE**  
 MAY 8 '57  
 o

Date Comm. \_\_\_\_\_  
 Location APR 10 '57 APR 17 '57 4-9-57  
8 7/8 936/500 @ 2850 APR 24 '57  
~~DST 5 1/2 13558~~ MAY 1 '57 DST  
3297-3320 1hr see 30' gas  
+30' ocm 845/15" 5 1/2 3360  
MAY 8 '57 PF Ark +st wtr co  
36/3027-35 1 1/2 - 8 14 Boph  
+55w 6 hrs Pop P. 25  
Boph + 55w