

Russell


KANSAS

SECTION 20 TOWNSHIP 12S RANGE 15W

WELL NO. #14 Krug

COMPANY Mast Drlg.

NORTH NW NE SE

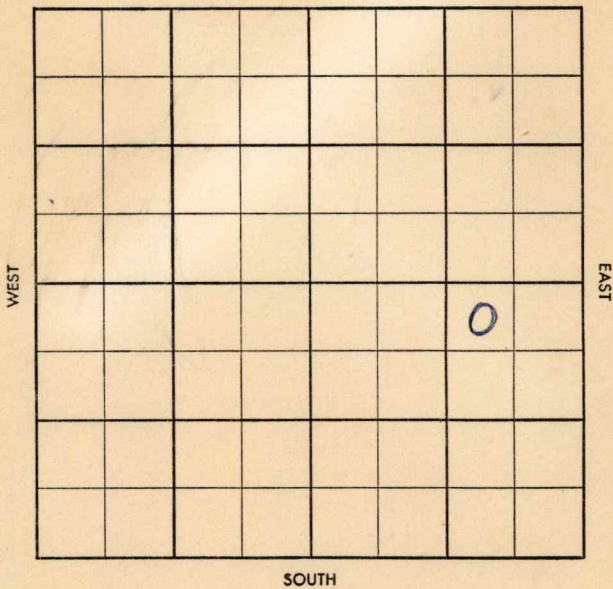

7

CO. Russell ELEV. _____
SEC. 20 TWP. 12 RGE. 15W
COMPANY Mast Drlg. NO. 4

FIRST REPORT

DEC	4	57	
			o

FARM Krug

LOC. NW NE SE

Anh.	915

GEOLOG. _____
CONTR. Co. tools
POOL Fairport
SPUD 11-27-57
8" @ 925 drlg. 2540

CO.
LSE.
NO.
SEC.
TWP.
RGE.

