


Section 11 Township 17 Range 13W

Well No. #1 Hitchman

Company Bay & Fleming & Woodman

NORTH

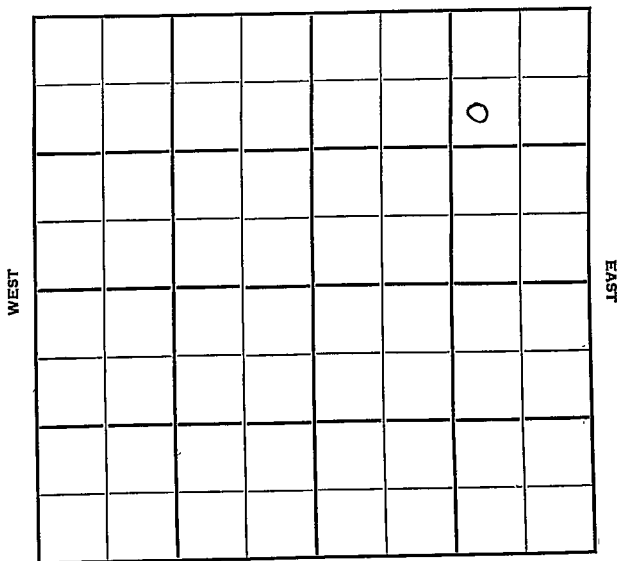

SOUTH



Sec. 11 Twp. 17 R. 13 W

Well No. # 1 Hitchman Farm

Bay & Fleming & Woodman Company

Woodman Contractor


990 Ft. from N. Line

Ft. from S. Line

990 Ft. from E. Line

Ft. from W. Line

SW NE NE

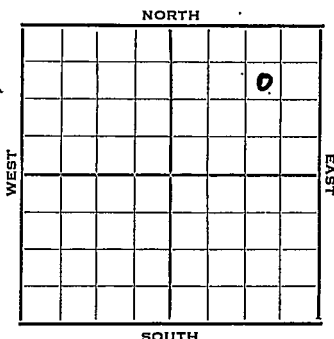

1952 Elev. 1867' REPORT

9/10 8" @ 178' Anhy 768'
Drlg. 1415'

9/17 Heeb 2997' Br li 3083' Lans 3102'
DST 3106-27, 3/4 hr, 5' OCM
DST 3218-36, 1/2 hr, 90' HO CM
300' oil 790#
DST 3258-93, 1 hr, 5' M
Drilling

9/24 Arb. 3335-37' RTD 5" @ 3336
CO 3337' B/1 BOPH 500 A S/4 1/2 BOPH

10/1 NR

10/8 "

10/15 "

10/22 "

10/29 Oil well TD 3337' 8" @ 178 Anhy 768'
Heeb 2997' Br. lime 3083' Lans. 3102'
DST 3106-27 open 3/4 hr. rec 5' OCM
off
DST 3218-36 open 1/2 hr. rec 90' HO CM,
900' oil, 790#
DST 3258-93 open 1 hr. rec 5' mud off
Arb. 3335-37' TD 5" @ 3336' GO to
3337' B/1 BOPH 500 A S/4 1/2 BOPH
Comp. 75 BOPD 38% wtr.

COMPLETED

J. G. McGEHEE

