


Barton county

Section 11 Township 17 Range 13-W

Well No. #4, Pearson

Company Black-Marshall

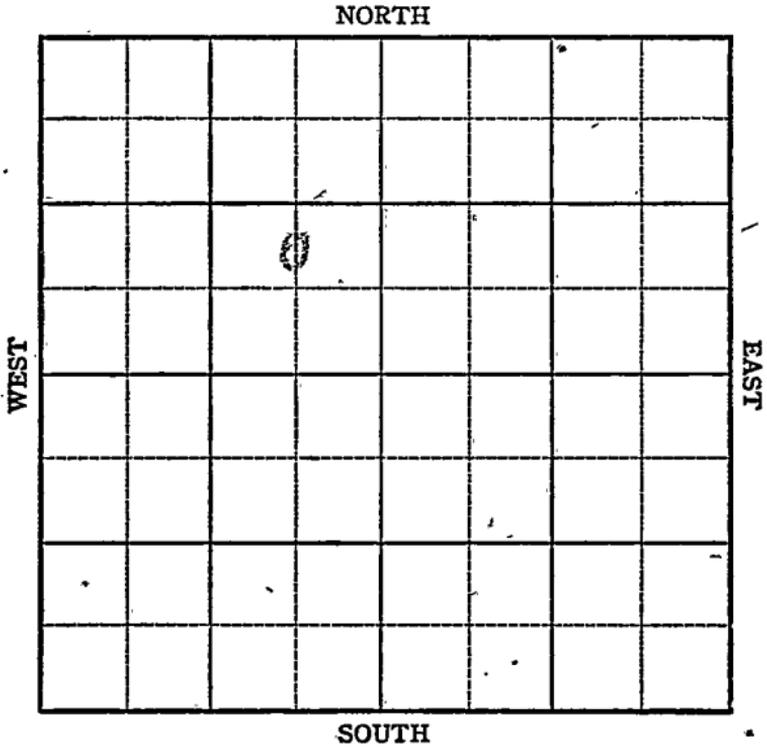

KANSAS

Barton

Sec. 11 Twp. 17 R. 13-W

Well No. #4 Pearson Farm


Black-Marshall Company

_____ Ft. from N. Line

990 Ft. from S. Line

660 Ft. from E. Line

_____ Ft. from W. Line

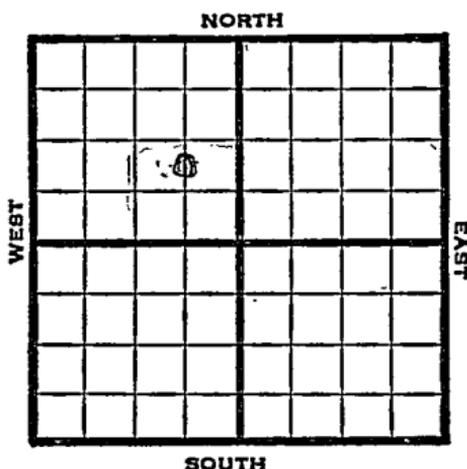

C N L SE NW

REPORT

1947 Elev. 1852

2/5 Surface hole

2/12 8" @ 200
Drlg 2724'

2/19 Lans 3090
Arb 3326'
TD 3330'

ABANDONED

Map No. 73 Sec. 11 Twp. 17 R. 13W

Well No. 4 Pearson

Black-Marshall Company

FIRST REPORT

Contractor

C N L SE NW

SECTION PLAT

_____ Ft. from N. Line

990 Ft. from S. Line

660 Ft. from E. Line

_____ Ft. from W. Line

	o		

Barton County

Location _____

Rig up _____

Drilling and Remarks:

surface hole

RECORD

Cased _____ in., _____ ft.

Sand _____

Gas _____

Oil _____

Total Depth _____

PRODUCTION

1st 24 hrs. Nat. _____

1st 24 hrs. after shot _____

Gas _____ Cu. Ft.

Dry Hole _____

Abandoned _____

Date

FEB 5 1947 19

S. J. LEWIS Scout

