

Section 27 Township 12 Range 9W

Well No. 1 Busick

Company Harry Miller

Wildcat

NORTH

		0					

WEST

EAST

SOUTH

3

Sec. 27 Twp. 12 R. 9-W ✓

Well No. #1 Busick Farm

Harry Miller Company

Wildcat


330 Ft. from N. Line

_____ Ft. from S. Line

_____ Ft. from E. Line

990 Ft. from W. Line

NW NE NW

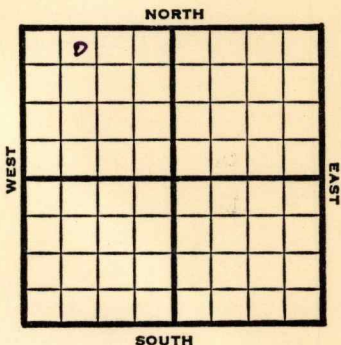

REPORT

1948

10/13

FT. Ruley 1262'

D&A

TD 1542'

FIRST REPORT

+

ABANDONED

Map No. 53 Sec. 27 Twp. 12 R. 9W

Well No. 1 Busick

Harry Miller Company

FIRST REPORT Contractor

NW NE NW

ABANDONED SECTION PLAT

330 Ft. from N. Line

_____ Ft. from S. Line

_____ Ft. from E. Line

990 Ft. from W. Line

	0		

Lincoln County

Location _____

Rig up _____

Drilling and Remarks:

Ft. Riley 1262

D & A

RECORD

Cased _____ in., _____ ft.

Sand _____

Gas _____

Oil _____

Total Depth 1542

PRODUCTION

1st 24 hrs. Nat. _____

1st 24 hrs. after shot _____

Gas _____ Cu. Ft.

Dry Hole _____

Abandoned _____

Date

OCT 13 1948 19

S. J. LEWIS Scout