

Lincoln

Map No. K Sec. 25 Twp. 12 R. 10^W


Well No. J Hall Farm
Surman dip Company

_____ Ft. from N. Line

200 Ft. from S. Line

200 Ft. from E. Line

_____ Ft. from W. Line

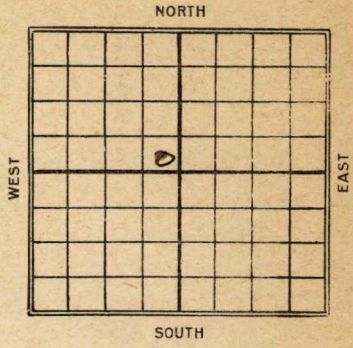

Date
1/9/24
4/9
4/24
8/10
11/23

REPORT

Location
U.R. 15 1/2" to 750'
1390
D. + A. 3500'

Map No. 25 Sec. 25 Twp. 12 R. 10W

Well No. #1 L Oehl

Sturman Oil Company

Contractor

FIRST REPORT

SECTION PLAT

-----Ft. from N. Line
200' Ft. from S. Line
200' Ft. from E. Line
 -----Ft. from W. Line

		0	

Location ✓✓

Rig up -----

Drilling and Remarks:

RECORD

Cased ----- in., ----- ft.
 Sand -----
 Gas -----
 Oil -----
 Total Depth -----

PRODUCTION

1st 24 hrs. Nat. -----
 1st 24 hrs. after shot -----
 Gas ----- Cu. Ft.
 Dry Hole -----
 Abandoned -----

Date
APR 9 1924
 ----- 192 -----

BENEAR
 ----- Scout

KANSAS

Lincoln Co.

Map No. _____ Sec. 25 Twp. 12 R. 10W

Well No. 1 Loh

Turman et al

Company

Contractor

ABANDONED

SECTION PLAT

_____ Ft. from N. Line

200 Ft. from S. Line

200 Ft. from E. Line

_____ Ft. from W. Line

		0	

Location _____

Rig up _____

Drilling and Remarks:

Loh 9
3500'

RECORD

Cased _____ in., _____ ft.

Sand _____

Gas _____

Oil _____

Total Depth _____

PRODUCTION

1st 24 hrs. Nat. _____

1st 24 hrs. after shot _____

Gas _____ Cu. Ft.

Dry Hole _____

Abandoned _____

Date

NOV 23 1924

192

M. A. BENEAR

Scout

MAP NO. _____ SEC. 75 TWP. 12S R. 10W

WELL NO. 1 H Hole

Dorman Oil COMPANY

no wall cup CONTRACTOR

SECTION PLAT

		0	

_____ FT. FROM N. LINE

_____ FT. FROM S. LINE

_____ FT. FROM E. LINE

_____ FT. FROM W. LINE

LOCATION _____

RIG UP _____

DRILLING AND REMARKS:

RECORD

CASED _____ IN. _____ FT.

SAND _____

GAS _____

OIL _____

TOTAL DEPTH 3210

PRODUCTION

1ST 24 HRS. NAT. _____

1ST 24 HRS. AFTER SHOT _____

GAS _____ CU. FT.

DRY HOLE ✓

ABANDONED ✓

DATE 9/11 192 4

SCOUT