

Section 32 Township 12 Range 11 W

Well No. # 1 Heine


Company Borrell & Miller

NORTH

WEST

EAST

SOUTH

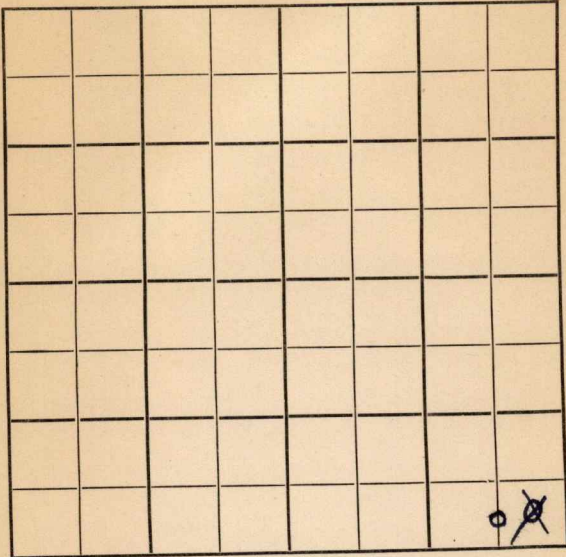



Sec. 32 Twp. 12 R. 11W

Well No. #1 Heine Farm

Borrell & Miller Company

Lewis Mai Contractor

Wildcat


Ft. from N. Line

330 Ft. from S. Line

~~660~~
330 Ft. from E. Line

Ft. from W. Line

CSLSESE
~~SESESE~~

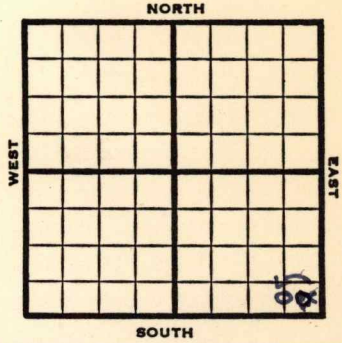

1953 **Elev. - 1533** REPORT

- 4/15 Location
- 4/23 8" @ 214
Anhy 442
Drlg. 2152'
- 4/30 **Heeb 2670, Tor 2693, Lans 2750, V 2256**
Drlg. 3382'
- 5/7 NR
- 5/13 Spud 4-16-53
D & A
TD 3540'
8" @ 214'
Anhy 442, Heeb 2670, Tor 2693, Lans 2750, Viola 3256, Simp 3419, Arb 3510,
TD 3540'
D & A.

ABANDONED

Map No. _____ Sec. 32 Twp. 12 R. 11W

Well No. 1 Heine

Borrell & Miller Company

CORRECTION

Contractor

C S L S E S E

SECTION PLAT

_____ Ft. from N. Line

330 Ft. from S. Line

660 Ft. from E. Line

_____ Ft. from W. Line

			o

Russell County

Location _____

Rig up _____

Drilling and Remarks:

Reported
SE SE SE

RECORD

Cased _____ in., _____ ft.

Sand _____

Gas _____

Oil _____

Total Depth _____

PRODUCTION

1st 24 hrs. Nat. _____

1st 24 hrs. after shot _____

Gas _____ Cu. Ft.

Dry Hole _____

Abandoned _____

Date

APR 2 1953 19

J. G. McGEHEE

Scout

