

KANSAS


Ottawa

FORM 51 5M 1-42 PETROL

Section 12 Township 12 Range 1-W

Well No. #1 K. Murphy Duggan

Company Stanolind

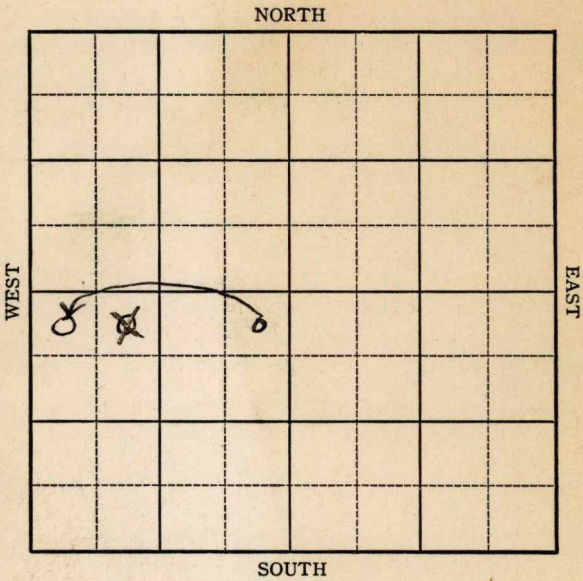

KANSAS

Ottawa

Sec. 12 Twp. 12 R. 1-W

Well No. #1 K. Murphy Duggan Farm


Stanolind Company

330 Ft. from N. Line

Ft. from S. Line

330 Ft. from E. Line

Ft. from W. Line

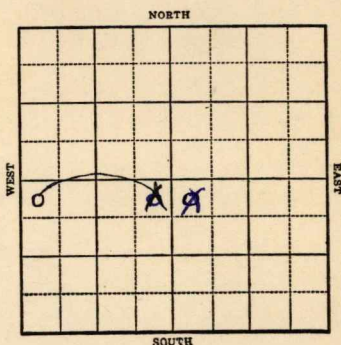

1943

Elev. 1318'

REPORT

11/10 Location

11/17 Rotary

11/24 Drlg. 1500'

12/1 Drlg. 2506'

12/8 T.D. 2506

This hole has been abandoned all the depth we have 2506'

~~ABANDONED~~

12/29 B/ Flo 505

Howard 1442

Topeka 1560

Hibs 1760

Lans 1905

BKC 2265

Miss 2550

Kind 2710

Hunton 2900

Sylvan 3015

Viola 3168

Simpson 3276

Arb 3360

TD 3401

D&A

This well abd Dec. 8, 1943 without tops.

~~ABANDONED~~

Ottawa

KANSAS

Map No. 5 Sec. 12 Twp. 12 R. 1WWell No. 1 K. Murphy Duggan

Stanolind

Company

~~FIRST~~
ABANDONED

Contractor

NW SW

SECTION PLAT

330 Ft. from N. Line

Ft. from S. Line

Ft. from E. Line

330 Ft. from W. Line

0			

Wildcat

Location

RECORD

Rig up

Cased _____ in., _____ ft.

Drilling and Remarks:

Sand _____

Gas _____

Oil _____

Total Depth 2506

*This hole has
been abandoned
all the depth.
We have 2506*

PRODUCTION

1st 24 hrs. Nat. _____

1st 24 hrs. after shot _____

Gas _____ Cu. Ft.

Dry Hole _____

Abandoned _____

Date

DEC 8 1943 19

S. J. LEWIS Scout

KANSAS
Map No. 51 Sec. 12 Twp. 12 R. 1W

Well No. 1 K. Murphy Duggan

Stanolind

Company

ABANDONED

Contractor

NW SW

SECTION PLAT

330 Ft. from N. Line

Ft. from S. Line

Ft. from E. Line

330 Ft. from W. Line

		E. 1/3/8	
0			

Wildcat

Location

Rig up

Drilling and Remarks:

B Flo 505

Howard 1442

Topeka 1560

Hibe 1760

Lans. 1905

B KC 2265

Miss 2550

Kind. 2710

(over)

RECORD

Cased _____ in., _____ ft.

Sand _____

Gas _____

Oil _____

Total Depth 3401

PRODUCTION

1st 24 hrs. Nat. _____

1st 24 hrs. after shot _____

Gas _____ Cu. Ft.

Dry Hole _____

Abandoned _____

Date

DEC 29 1943

19

S. J. LEWIS

Scout

Hunton 2900
 Sylvan 3015
 Viola 3168
 Simpson 3276
 Arb. 3360
 TD 3401

Moody Plat Book
 Geological Dept.
 Moody Map
 Scarborough Map
 France Map
 Tracing
 Cards
 Misc. Small Maps

This well abandoned bed 1943
 without tops

No small map - One

no

SECTION 16.1

Contractor

Company

Well No

J. K. ...

Map No

200

12

12

12

12

12

Form 10, 100 ft. 2-12-1904

Office

KANSAS

Map No. 51 Sec. 12 Twp. 12 R. 1WWell No. 1 K. Murphy Duggan

Stanolind

Company

CORRECTION

Contractor

NW SW

330 Ft. from N. Line

Ft. from S. Line

Ft. from E. Line

330 Ft. from W. Line

SECTION PLAT

o			

Wildcat

Location

Rig up

Drilling and Remarks:

Had spotted
wrong

RECORD

Cased _____ in., _____ ft.

Sand _____

Gas _____

Oil _____

Total Depth _____

PRODUCTION

1st 24 hrs. Nat. _____

1st 24 hrs. after shot _____

Gas _____ Cu. Ft.

Dry Hole _____

Abandoned _____

Date

NOV 24 1943

19

S. J. LEWIS

Scout

Ottawa

KANSAS

Map No. 51 Sec. 12 Twp. 12 R. 1WWell No. 1 K. Murphy Duggan

Stanolind

Company

FIRST REPORT

Contractor

NW SW


SECTION PLAT

330 Ft. from N. Line

Ft. from S. Line

330 Ft. from E. Line

Ft. from W. Line

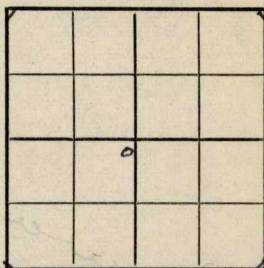

Wildcat

Location X

Rig up

Drilling and Remarks:

RECORD

Cased _____ in., _____ ft.

Sand _____

Gas _____

Oil _____

Total Depth _____

PRODUCTION

1st 24 hrs. Nat. _____

1st 24 hrs. after shot _____

Gas _____ Cu. Ft.

Dry Hole _____

Abandoned _____

Date

NOV 10 1943 19

S. J. LEWIS

Scout