

KANSAS


Barton

FORM 51 5M 1-42 PETROL

Section 11 Township 17 Range 13-W

Well No. #1 Pearson

Company Barby

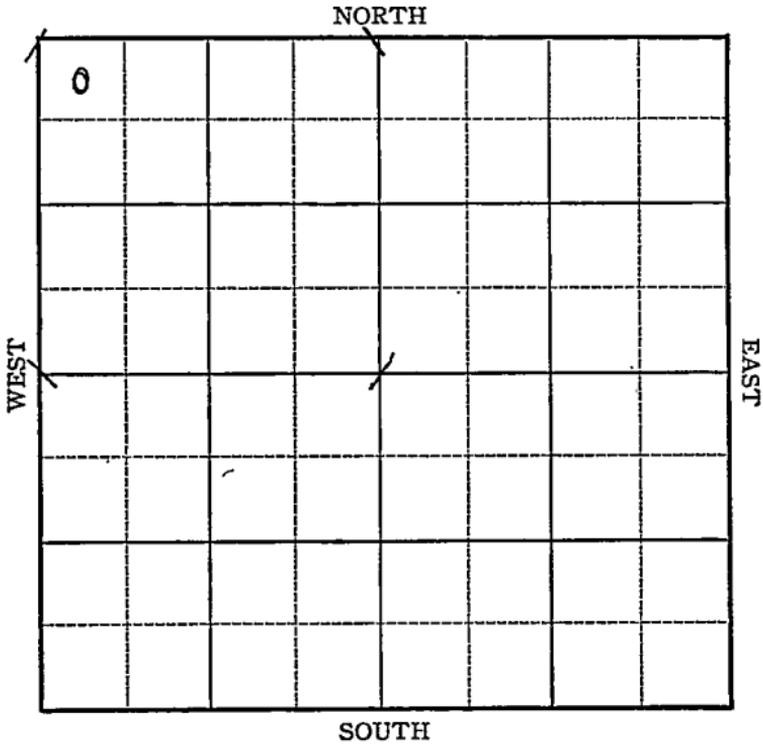

KANSAS

Barton

Sec. 11 Twp. 17 R. 13-W

Well No. #1 Pearson Farm

Darby Company

Ainsworth


330 Ft. from N. Line

_____ Ft. from S. Line

_____ Ft. from E. Line

330 Ft. from W. Line

elev. 1916

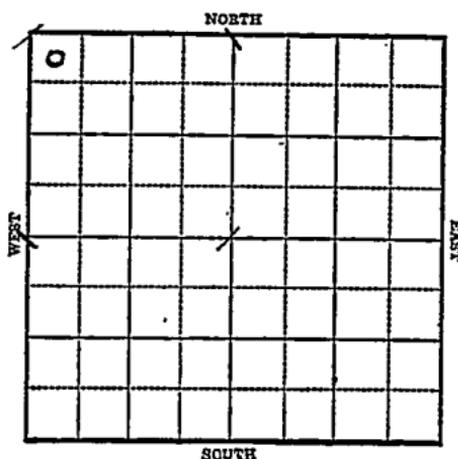

1943

R E P O R T

- 5/26 Location.
- 6/2 Rotary
- 6/9 Anhy 810
10" @ 818
Drig. 2000'
- 6/16 Topeka 2800
Lans 3129
Arb 3372-76 T.D.
Poro & Sat
Run Csgl.
- 6/23 5" @ 3372'
T.D. 3398
50' oil 400' water 1½ hrs SD
- 6/30 Arb. 3371
T.D. 3398'
Water

ABANDONED

KANSAS

Barton

Map No. 3 Sec. 11 Twp. 17 R. 13WWell No. 1 Pearson

Darby

Company

FIRST REPORT

Contractor

NW/C

330 Ft. from N. Line Ft. from S. Line Ft. from E. Line330 Ft. from W. Line

SECTION PLAT

0			

AINSWORTH POOL

Location XXXRig up

Drilling and Remarks:

RECORD

Cased in., ft.Sand Gas Oil Total Depth

PRODUCTION

1st 24 hrs. Nat. 1st 24 hrs. after shot Gas Cu. Ft.Dry Hole Abandoned

Date

MAY 2 6 1943 19S. J. LEWIS Scout

Barton

KANSAS

Map No. 73 Sec. 11 Twp. 17 R. 13W

Well No. 1 Pearson

Darby

Company

ABANDONED

Contractor

SECTION PLAT

NW/C

330 Ft. from N. Line

_____ Ft. from S. Line

_____ Ft. from E. Line

330 Ft. from W. Line

o			

AINSWORTH POOL

Location _____

Rig up _____

Drilling and Remarks:

Cor 43371

Water

RECORD

Cased _____ in., _____ ft.

Sand _____

Gas _____

Oil _____

Total Depth 3398

PRODUCTION

1st 24 hrs. Nat. _____

1st 24 hrs. after shot _____

Gas _____ Cu. Ft.

Dry Hole _____

Abandoned _____

Date

JUN. 3 0 1943 19

S. J. LEWIS Scout